

CARD MUST BE TYPED

State of Kansas  
NOTICE OF INTENTION TO DRILL

248 Collector  
CARD MUST BE SIGNED  
9-26-85

\*\*Corrected location\*\*

(see rules on reverse side)

Starting Date: .....9.....30.....85.....  
month day year

API Number 15-101-21,229 - 0000

\*\* 100' South  
\* NE SE NW \* Sec 36 Twp 16 S, Rge 30.  East  
(location)  West

OPERATOR: License # .....5151.....  
Name .....Gear Petroleum Co., Inc.....  
Address .....300 Sutton Place.....  
City/State/Zip .....Wichita, KS 67202.....  
Contact Person .....Jim Thatcher.....  
Phone .....316-265-3351.....

\* .....3530..... Ft North from Southeast Corner of Section  
\* .....2970..... Ft West from Southeast Corner of Section  
(Note: Locate well on Section Plat on reverse side)

CONTRACTOR: License # .....5302.....  
Name .....Red Tiger Drilling Co.....  
City/State .....Wichita, KS.....

Nearest lease or unit boundary line .....330..... feet.  
County .....Lane.....  
Lease Name .....Kropp..... Well# 2-36.....  
Domestic well within 330 feet:  yes  no  
Municipal well within one mile:  yes  no

Well Drilled For: Well Class: Type Equipment:  
 Oil  Swd  Infield  Mud Rotary  
 Gas  Inj  Pool Ext.  Air Rotary  
 OWWO  Expl  Wildcat  Cable

Depth to Bottom of fresh water .....200..... feet  
Lowest usable water formation .....Dakota.....  
Depth to Bottom of usable water .....1200..... feet  
Surface pipe by Alternate: 1  2   
Surface pipe to be set .....320..... feet  
Conductor pipe if any required .....none..... feet  
Ground surface elevation .....2843'..... feet MSL  
This Authorization Expires .....3-78-86.....  
Approved By .....9-18-85.....

If OWWO: old well info as follows:

Operator .....  
Well Name .....  
Comp Date ..... Old Total Depth .....  
Projected Total Depth .....4650..... feet  
Projected Formation at TD .....Mississippi.....  
Expected Producing Formations .....Cherokee.....

I certify that we will comply with K.S.A. 55-101, et seq., plus eventually plugging hole to K.C.C. specifications.

Kwas' CSENE 3300 FSL  
660 FEL


Date .....9-25-85..... Signature of Operator or Agent *Jim Thatcher*

Title Production Engineer.....

Must be filed with the K.C.C. five (5) days prior to commencing well  
This card void if mutilated or started within six (6) months of date received by K.C.C.  
**RECEIVED**  
STATE CORPORATION COMMISSION

SEP 26 1985  
9-26-85

**A Regular Section of Land CONSERVATION DIVISION**  
1 Mile = 5,280 Ft. Wichita, Kansas

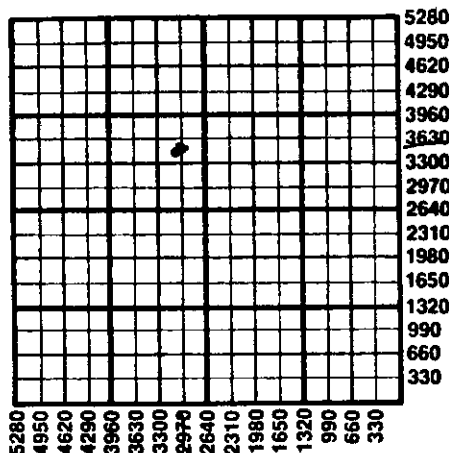

**Important procedures to follow :**

1. Notify District office before setting surface casing.
2. Set surface casing by circulating cement to the top.
3. File completion forms ACO-1 with K.C.C. within 90 days of well completion, following instructions on ACO-1, side 1, and including copies of wireline logs.
4. Notify District office 48 hours prior to old well workover or re-entry.
5. Prior to plugging, prepare a plugging plan, then obtain agreement from the appropriate district office for an approved plugging plan.
6. Submit plugging report (CP-4) to K.C.C. after plugging is completed.
7. Obtain an approved injection docket number before disposing of salt water.
8. Notify K.C.C. within 10 days when injection commences or terminates.
9. If an alternate 2 completion, cement in the production pipe from below any usable water to surface within 120 days of spud date.

State Corporation Commission of Kansas  
Conservation Division  
200 Colorado Derby Building  
Wichita, Kansas 67202  
(316) 263-3238