

## NOTICE OF INTENTION TO DRILL

(see rules on reverse side)

Expected Spud Date... November 17, 1988  
month day year

API Number 15-101-21,494-0000

OPERATOR: License # 5104W/2 W/2 SW. Sec. 35... Twp. 16. S, Rg. 30... X EastName Blue Goose Drilling Company, Inc.1320 Ft. from South Line of SectionAddress P.O. Box 14134950 Ft. from East Line of SectionCity/State/Zip Great Bend, KS 67530

(Note: Locate well on Section Plat on reverse side)

Contact Person Martin E. MillerNearest lease or unit boundary line 330 feetPhone 316 792-5633County LaneCONTRACTOR: License # 5104Lease Name Snider Well # 1Name Company ToolsGround surface elevation unknown feet MSLCity/State sameDomestic well within 330 feet: X yes \_\_\_ no

Well Drilled For: Well Class: Type Equipment:

Municipal well within one mile: X yes \_\_\_ noX Oil \_\_\_ Storage \_\_\_ Infield X Mud RotaryDepth to bottom of fresh water... 200\_\_\_ Gas \_\_\_ Inj X Pool Ext. \_\_\_ Air RotaryDepth to bottom of usable water 1250

\_\_\_ OWWO \_\_\_ Expl \_\_\_ Wildcat \_\_\_ Cable

Surface pipe by Alternate: 1 \_\_\_ 2 X

If OWWO: old well info as follows:

Surface pipe planned to be set 200'

Operator .....

Conductor pipe required n/a

Well Name .....

Projected Total Depth 4600' feet

Comp Date ..... Old Total Depth.....

Formation Mississippian

I certify that well will comply with K.S.A. 55-101, et seq., plus eventually plugging hole to KCC specifications.

Date 11/3/88 Signature of Operator or Agent Martin E. Miller Title Contracts/Exploration

For KCC Use:


Conductor Pipe Required ..... feet; Minimum Surface Pipe Required 200' feet per Alt. DX (2)This Authorization Expires 5-1-89 Approved By LKM 11-9-88EFFECTIVE DATE: 11-9-88

Must be filed with the K.C.C. five (5) days prior to commencing well  
This card void if drilling not started within six (6) months of date received by K.C.C.

**Important procedures to follow:**

1. Notify District office before setting surface casing.
2. Set surface casing by circulating cement to the top.
3. File completion forms ACO-1 with K.C.C. within 120 days of well spud date, following instructions on ACO-1, side 1, and including copies of wireline logs.
4. Notify District office 48 hours prior to old well workover or re-entry.
5. Prior to filing Intent, prepare a proposed plugging plan in case well is D & A, then obtain approval of plan when calling district office prior to setting surface pipe.
6. Submit plugging report (CP-4) to K.C.C. after plugging is completed.
7. Obtain an approved injection docket number before disposing of salt water.
8. Notify K.C.C. within 10 days when injection commences or terminates.
9. If an alternate 2 completion, cement in the production pipe from below any usable water to surface within 120 days of spud date.

**A Regular Section of Land  
1 Mile = 5,280 Ft.**

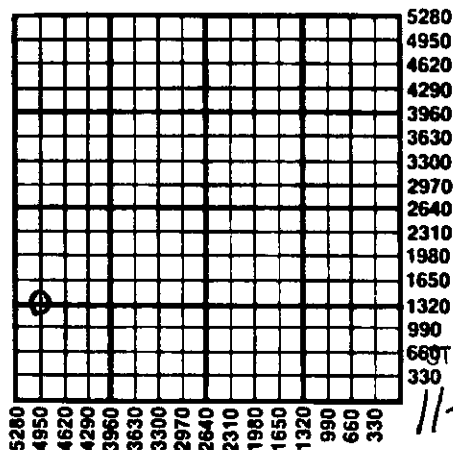

RECEIVED  
STATE CORPORATION COMMISSION

11-4-88  
NOV 4 1988

CONSERVATION DIVISION  
Wichita, Kansas

State Corporation Commission of Kansas  
Conservation Division  
200 Colorado Derby Building  
Wichita, Kansas 67202-1212  
(316) 263-3238