

CARD MUST BE TYPED

State of Kansas

CARD MUST BE SIGNED ✓

NOTICE OF INTENTION TO DRILL

(see rules on reverse side)

Starting Date 6 month 15 day 1987 year

API Number 15- 135-23,125-0000

OPERATOR: License # 5652

..... East
C. NW. NE.. Sec 34 Twp. 20 S, Rg. 25 X West

Name MUSTANG COMPANIES, INC.

..... 4620 Ft. from South Line of Section

Address P.O. Drawer 1609

..... 1980 Ft. from East Line of Section

City/State/Zip Great Bend, KS 67530

(Note: Locate well on Section Plat on reverse side)

Contact Person James Meroney

Nearest lease or unit boundary line 660 feet

Phone 316-792-7323

County Ness

CONTRACTOR: License # 5652

Lease Name... Fehrenbach Well # . 3-34

Name MUSTANG COMPANIES, INC.

Ground surface elevation feet MSL

City/State... Great Bend, KS 67530

Domestic well within 330 feet: yes X no

Well Drilled For: Well Class: Type Equipment:

Municipal well within one mile: yes X no

X Oil SWD Infield Mud Rotary

Depth to bottom of fresh water 330

Gas Inj Pool Ext Air Rotary

Depth to bottom of usable water 750

OWWO Expl Wildcat Cable

Surface pipe by Alternate: 1 X 2

If OWWO: old well info as follows:

Surface pipe planned to be set 750

Operator

Conductor pipe required None

Well Name

Projected Total Depth .. 4550 feet

Comp Date Old Total Depth.....

Formation... Mississippi

I certify that well will comply with K.S.A. 55-101, et seq., plus eventually plugging hole to KCC specifications.

Date 5-20-87 Signature of Operator or Agent

Title... Exploration Geologist

For KCC Use:

Conductor Pipe Required feet; Minimum Surface Pipe Required 750 feet per Alt. 04


This Authorization Expires 11-21-87 Approved By 5-21-87

Must be filed with the K.C.C. five (5) days prior to commencing well
This card void if drilling not started within six (6) months of date received by K.C.C.

Important procedures to follow:

1. Notify District office before setting surface casing.
2. Set surface casing by circulating cement to the top.
3. File completion forms ACO-1 with K.C.C. within 90 days of well completion, following instructions on ACO-1, side 1, and including copies of wireline logs.
4. Notify District office 48 hours prior to old well workover or re-entry.
5. Prior to filing Intent, prepare a proposed plugging plan in case well is D & A, then obtain approval of plan when calling district office prior to setting surface pipe.
6. Submit plugging report (CP-4) to K.C.C. after plugging is completed.
7. Obtain an approved injection docket number before disposing of salt water.
8. Notify K.C.C. within 10 days when injection commences or terminates.
9. If an alternate 2 completion, cement in the production pipe from below any usable water to surface within 120 days of spud date.

A Regular Section of Land
1 Mile = 5,280 Ft.

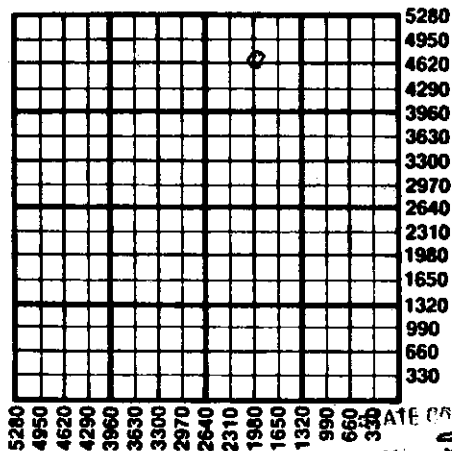

RECEIVED
STATE CORPORATION COMMISSION

5-21-87
MAY 21 1987

CONSERVATION DIVISION
Wichita, Kansas

State Corporation Commission of Kansas
Conservation Division
200 Colorado Derby Building
Wichita, Kansas 67202
(316) 263-3238