


STATE OF KANSAS  
STATE CORPORATION COMMISSION

WELL PLUGGING RECORD

Give All Information Completely  
Make Required Affidavit  
Mail or Deliver Report to  
Conservation Division  
State Corporation Comm.  
245 North Water  
Wichita, KS 67202

Ness County, Sec. 35 Twp. 20S Rge. 25W E4W  
Location as "NE/CNW/SW" or footage from lines  
C-SW NW

Lease Owner The National Oil Company  
Lease Name Almquist Well No. 2  
Office Address Suite 550, O.W. Garvey Bldg., Wichita, KS  
Character of Well (Completed as Oil, Gas or Dry Hole) 67202  
Dry Hole

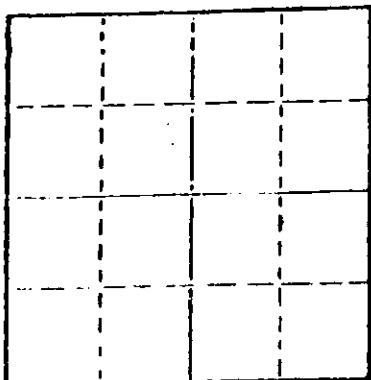

Locate well correctly on above  
Section Plot

Date Well completed January 16, 1979  
Application for plugging filed Verbal Application 1979  
Application for plugging approved Verbal Approval 1979  
Plugging commenced January 16, 1979  
Plugging completed January 16, 1979  
Reason for abandonment of well or producing formation \_\_\_\_\_

If a producing well is abandoned, date of last production \_\_\_\_\_ 19\_\_\_\_

Was permission obtained from the Conservation Division or its agents before plugging was commenced? Yes

Name of Conservation Agent who supervised plugging of this well Wm. T. Owen  
Producing formation \_\_\_\_\_ Depth to top \_\_\_\_\_ Bottom \_\_\_\_\_ Total Depth of Well 4,520'  
Show depth and thickness of all water, oil and gas formations.

OIL, GAS OR WATER RECORDS

CASING RECORD

FORMATION	CONTENT	FROM	TO	SIZE	PUT IN	PULLED OUT
				8-5/8"	405'	None

Describe in detail the manner in which the well was plugged, indicating where the mud fluid was placed and the method or methods used in introducing it into the hold. If cement or other plugs were used, state the character of same and depth placed, from \_\_\_\_\_ feet to \_\_\_\_\_ feet for each plug set.

Filled hole with heavy rotary mud from 4,520 ft. (rotary total depth) to 550 ft. Set plug at 550 ft. and cemented with 70 sacks cement. Filled hole with heavy rotary mud from 550 ft. to 240 ft. Set plug at 240 ft. and cemented with 20 sacks cement. Filled hole with heavy rotary mud from 240 ft. to 40 ft. Set solid plug at 40 ft. and cemented to cellar with 10 sacks cement, 3 sacks cement in rat hole.

Plugging operations accomplished utilizing Allied Oil Well cementing pump truck through 4 1/2 inch drill pipe.

(If additional description is necessary, use BACK of this sheet)

Name of Plugging Contractor Allied Cementing Co., Inc.  
Box 31, Russell, Kansas 67665

STATE OF Kansas COUNTY OF Sedgwick, ss.  
Dean Britting, Agent ~~XXXXXX~~ of owner ~~XXXXXXXXXXXXXXXXXX~~

of the above-described well, being first duly sworn on oath, says: That I have knowledge of the facts, statements, and matters herein contained and the log of the above-described well as filed and that the same are true and correct. So help me God.


(Signature) Dean Britting  
200 N. Main, Wichita, KS 67202  
(Address)

SUBSCRIBED AND SWORN TO before me this 22nd day of January, 19 79



Elsie Willison  
Notary Public.

My commission expires July 25, 1982

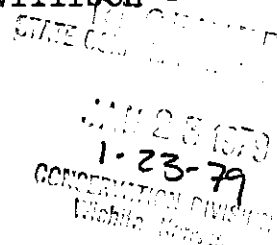

KANSAS DRILLERS LOG

COMPANY The National Oil Company

SEC. 35 T. 20S. 25W  
LOC. C-SW NW

FARM Almquist NO. 2

COUNTY Ness

ROTARY TOTAL DEPTH 4,520'

COMM. January 4, 1979 COMP. January 16, 1979

CONTRACTOR H-30, Inc. (Rig #2)

ISSUED January 22, 1979

CASING

10 3/4"

8 5/8" Set at 405' cemented w/225 sxs cement

5 1/2"

4 1/2"

ELEVATION 2,389' K.B.

FIGURES INDICATE BOTTOM OF FORMATIONS

Sand and Shale	409'
Shale	1,030'
Sand and Shale	1,519'
Shale	1,622'
Anhydrite	1,677'
Shale and Shells	2,005'
Lime and Shale	2,340'
Shale and Shells	2,380'
Lime and Shale	2,580'
Shale and Lime	2,730'
Lime	4,520'
Rotary Total Depth	4,520'

I hereby certify the above and foregoing to be a true and correct log of the above described well as shown by the drilling reports.



H-30, Inc.

*Dean Britting*  
Dean Britting

State of Kansas }  
County of Sedgwick } SS:

Subscribed and Sworn to before me a Notary Public

in and for said county and state this 22nd day of January, 1979.

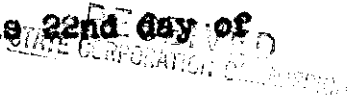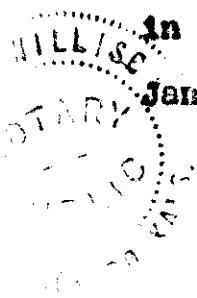

JAN 23 1979  
1-23-79  
CONSERVATION DIVISION

*Elsie Willison*  
Elsie Willison - Notary Public

My Commission Expires:

July 25, 1982