15-135-20526-0000


STATE OF KANSAS
STATE CORPORATION COMMISSION

Form CP-4

Give All Information Completely
Make Required Affidavit
Mail or Deliver Report to:
Conservation Division
State Corporation Commission
212 No. Market
Wichita, Kansas

WELL PLUGGING RECORD

NORTH

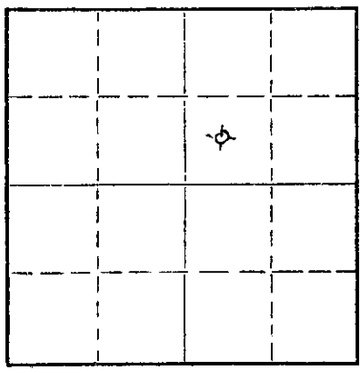

Locate well correctly on above Section Plat

Ness County. Sec. 36 Twp. 20S Rge. 25 (E) W (W)

Location as "NE/CNW¼SW¼" or footage from lines C SW NE

Lease Owner Murfin Drilling Company

Lease Name Schneider Well No. 1

Office Address 617 Union Center, Wichita, Kansas 67202

Character of Well (completed as Oil, Gas or Dry Hole) Dry Hole

Date well completed 12-7 19 71

Application for plugging filed 12-7 19 71

Application for plugging approved 12-7 19 71

Plugging commenced 12-7 19 71

Plugging completed 12-7 19 71

Reason for abandonment of well or producing formation D & A

If a producing well is abandoned, date of last production 19

Was permission obtained from the Conservation Division or its agents before plugging was commenced? Yes

Name of Conservation Agent who supervised plugging of this well Leo Massey, Hays, Kansas

Producing formation Depth to top Bottom Total Depth of Well 4585 Feet

Show depth and thickness of all water, oil and gas formations.

OIL, GAS OR WATER RECORDS — CASING RECORD

FORMATION	CONTENT	FROM	TO	SIZE	PUT IN	PULLED OUT

Describe in detail the manner in which the well was plugged, indicating where the mud fluid was placed and the method or methods used in introducing it into the hole. If cement or other plugs were used, state the character of same and depth placed, from feet to feet for each plug set.

680' w/50 sxs
450' w/25 sxs
40' w/10 sxs

RECEIVED
STATE CORPORATION COMMISSION
12-15-71
DEC 17 1971
CONSERVATION DIVISION
Wichita, Kansas

(If additional description is necessary, use BACK of this sheet)

Name of Plugging Contractor Murfin Drilling Company

Address 617 Union Center, Wichita, Kansas 67202

STATE OF KANSAS, COUNTY OF SEDGWICK, ss.

James R. Daniels (employee of owner) or (owner or operator) of the above-described well, being first duly sworn on oath, says: That I have knowledge of the facts, statements, and matters herein contained and the log of the above-described well as filed and that the same are true and correct. So help me God.

(Signature) James R Daniels

617 Union Center, Wichita, Kansas 67202
(Address)

SUBSCRIBED AND SWORN TO before me this 15th day of December, 1971

Wilma V. Brokes
Notary Public.

My commission expires February 7, 1975

15-135-20526-0000

WELL LOG

COMPANY Murfin Drilling Company

FARM Schneider NO. 1

RIG. NO. 2

TOTAL DEPTH 4585'

COMM. 11-26-71 COMP. 12-7-71

CONTRACTOR Murfin Drilling Company


SEC. 36 T. 20S R. 25W

LOC. C SW NE

Ness

COUNTY

KANSAS

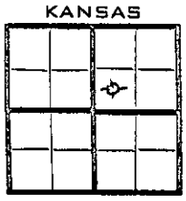

CASING

20	10	
15	8	5/8" @ 499' w/300 sxs
12	6	
13	5	

ELEVATION 2380 GL
2385 KB

PRODUCTION D & A

FIGURES INDICATE BOTTOM OF FORMATIONS

400	Sand Shale
502	Shale
1075	Shale - Red Bed
1130	Shale
1285	Sand
1830	Shale - Red Bed
2650	Lime & Shale
4456	Lime
4485	Lime & Chert
4585	Lime

RECEIVED
STATE CORPORATION COMMISSION
DEC 17 1971
CONSERVATION DIVISION
Wichita, Kansas

State of KANSAS }
County of SEDGWICK } ss:

I, James R. Daniels of the Murfin Drilling Company

upon oath state that the above and foregoing is a true and correct copy of the log of the Schneider #1 well.

James R. Daniels

Subscribed and sworn to before me this 15th day of December 19 71

My Commission Expires: February 7, 1975

Wilma V. Brokes
NOTARY PUBLIC
Wilma V. Brokes

DP28