


15-155-20255-0000

STATE OF KANSAS  
STATE CORPORATION COMMISSION  
CONSERVATION DIVISION  
P. O. BOX 17027  
WICHITA, KANSAS 67217

FORM CP-4

WELL PLUGGING RECORD

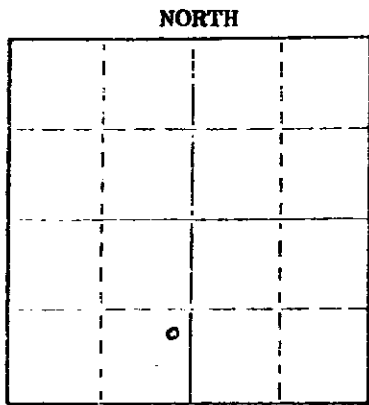

Reno County, Sec. 11 Twp 23 Rge. (E) 10 (W)  
Location as "NE/CNW/SE/SW" or footage from lines NE SE SW  
Lease Owner Cities Service Oil Company  
Lease Name Tomn Well No. A-1  
Office Address 209 E. William, 700 Sutton Place, Wichita, Ks.  
Character of Well (completed as Oil, Gas or Dry Hole) Dry Hole  
Date well completed September 30 19 74  
Application for plugging filed September 30 19 74  
Application for plugging approved September 30 19 74  
Plugging commenced September 30 19 74  
Plugging completed September 30 19 74  
Reason for abandonment of well or producing formation Dry Hole

If a producing well is abandoned, date of last production 19  
Was permission obtained from the Conservation Division or its agents before plugging was commenced? Yes

Name of Conservation Agent who supervised plugging of this well Gilbert Toman  
Producing formation \_\_\_\_\_ Depth to top \_\_\_\_\_ Bottom \_\_\_\_\_ Total Depth of Well 3783'  
Show depth and thickness of all water, oil and gas formations.

OIL, GAS OR WATER RECORDS

CASING RECORD

FORMATION	CONTENT	FROM	TO	SIZE	PUT IN	PULLED OUT

RECEIVED  
STATE CORPORATION COMMISSION  
OCT 7 1974  
CONSERVATION DIVISION  
Wichita, Kansas

Describe in detail the manner in which the well was plugged, indicating where the mud fluid was placed and the method or methods used in introducing it into the hole. If cement or other plugs were used, state the character of same and depth placed, from \_\_\_\_\_ feet to \_\_\_\_\_ feet for each plug set.

Set Plug @ 500' w/40 sacks cement thru drill pipe.  
Come up hole to 250' - set plug w/25 sacks cement thru drill pipe.  
Top plug set @ 40' w/10 sacks cemen.  
3 sacks cement in rat hole.

Name of Plugging Contractor Duke Drilling Company  
Address Box 823, Great Bend, Kansas

STATE OF Kansas COUNTY OF Barton ss.  
Wayne Dobbs (employee of owner) or (owner or operator) of the above-described

well, being first duly sworn on oath, says: That I have knowledge of the facts, statements, and matters herein contained and the log of the above-described well as filed and that the same are true and correct. So help me God.

(Signature) Wayne Dobbs  
Box 823, Great Bend, Kansas 67530  
(Address)

SUBSCRIBED AND SWORN TO before me this 1st day of October 19 74

My commission expires April 11, 1978  
Notary Public.

DATE COMMENCED: September 17, 1974  
 DATE COMPLETED: September 30, 1974

Cities Service Oil Company  
 TOWN A-1  
 NE SE SW  
 Sec. 11-23-10N  
 Reno County, Kansas

ELEVATION: 1756 K.B.

0 - 75'	Sand & Clay
75 - 555'	Red Bed
555 - 805'	Shale
805 - 850'	Red Bed
850 - 1100'	Shale w/Lime Streaks
1100 - 1370'	Shale & Lime
1370 - 1385'	Anhydrite
1385 - 2770'	Shale & Lime, Sand
2770 - 3075'	Lime
3075 - 3077'	Shale
3077 - 3257'	Lime & Shale
3257 - 3555'	Lime
3555 - 3610'	Lime & Shale
3610 - 3743'	Shale & Sand
3743 - 3783'	Lime
3783 - 3783'	RED

FORMATION TOPS

Anhydrite	1370
Harrington	1500
Winfield	1556
St. Riley	1580
Tarrio	2430
Severy	2725
Topoka	2770
Heebner	3075
Toronoto	3070
Lancaster	3257
Base K.C.	3555
Kinderhook	3610
Viola	3743
RED	3783

RECEIVED  
 STATE CORPORATION COMMISSION

OCT 7 1974

CONSERVATION DIVISION  
 Wichita, Kansas

SURFACE PIPE: Set 3 5/8", 20' new  
 pipe @ 259' w/165 sacks 50/50 Pozmix,  
 35 cc.

AFFIDAVIT

STATE OF KANSAS }  
 COUNTY OF BARTON } ss.

Wayne Dobbs, of lawful age, does swear and state that the facts and statements herein contained are true and correct to the best of his knowledge.

Wayne Dobbs

Subscribed and sworn to before me this 1st day of October, 1974.

Neathy M. Hague  
 Notary Public

My Commission Expires: April 11, 1978