


STATE OF KANSAS
STATE CORPORATION COMMISSION

Give All Information Completely
Make Required Affidavit
Mail or Deliver Report to:
Conservation Division
State Corporation Commission
211 No. Broadway
Wichita, Kansas

WELL PLUGGING RECORD

15-135-19171-0000

NORTH

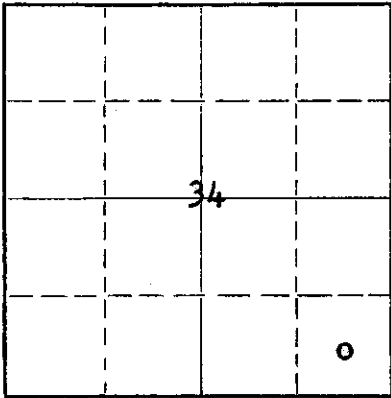

Locate well correctly on above
Section Plat

Ness

County. Sec. 34 Twp. 20 Rge. 25 (E) W (W)

Location as "NE/CNW/SW" or footage from lines C SE SE
Lease Owner Wilcox Oil Company
Lease Name McGinnis Well No. 1
Office Address Box 1440, Tulsa, Oklahoma
Character of Well (completed as Oil, Gas or Dry Hole) Dry Hole
Date well completed October 29, 1962
Application for plugging filed October 31, 1962
Application for plugging approved November 2, 1962
Plugging commenced November 6, 1962 1962
Plugging completed November 7, 1962 1962
Reason for abandonment of well or producing formation Dry Hole

If a producing well is abandoned, date of last production 19
Was permission obtained from the Conservation Division or its agents before plugging was commenced? Yes

Name of Conservation Agent who supervised plugging of this well Eldon Petty, Hays, Kansas
Producing formation _____ Depth to top _____ Bottom _____ Total Depth of Well 4600 Feet
Show depth and thickness of all water, oil and gas formations.

OIL, GAS OR WATER RECORDS

CASING RECORD

FORMATION	CONTENT	FROM	TO	SIZE	PUT IN	PULLED OUT
Mississippi	Oil & Wtr.	4472	4506	8-5/8"	397	None
				5-1/2"	4600	3362

Describe in detail the manner in which the well was plugged, indicating where the mud fluid was placed and the method or methods used in introducing it into the hole. If cement or other plugs were used, state the character of same and depth placed, from _____ feet to _____ feet for each plug set.

Filled hole from 4550' to 4460' W/cement. Filled hole W/heavy rotary mud. Shot off pipe @ 3362'. Hole was kept full of rotary mud while pipe was being pulled. Cement plug was placed in hole @ 600' (26 sacks). Placed Bridge (cement 36 sacks) 200' from surface in surface casing. Filled in cellar with earth.

RECEIVED
STATE CORPORATION COMMISSION

NOV 15 1962

CONSERVATION DIVISION
Wichita, Kansas

(If additional description is necessary, use BACK of this sheet)

Name of Plugging Contractor Ralph Comstock Pipe Pulling Company
Address Stafford, Kansas

STATE OF Oklahoma, COUNTY OF Tulsa, ss.
J. B. Cruikshank (employee of owner) or (owner or operator) of the above-described

well, being first duly sworn on oath, says: That I have knowledge of the facts, statements, and matters herein contained and the log of the above-described well as filed and that the same are true and correct. So help me God.

(Signature)

P. O. Box 1440, Tulsa, Oklahoma

(Address)

SUBSCRIBED AND SWORN TO before me this 14th day of November, 19 62

My commission expires Dec. 29, 1962

Thelma Dodge
Notary Public.

WELL LOG

15-135-19171-0000

COMPANY WILCOX OIL COMPANY

SEC. 34 T. 20S R. 25W

FARM MCGINNIS

NO. 1

LOC. C-SE, SE

TOTAL DEPTH 4600'

COUNTY NESS CO., KANSAS


COMM. August 17, 1962

COMP. August 30, 1962

CONTRACTOR

GARVEY DRILLING COMPANY

CASING

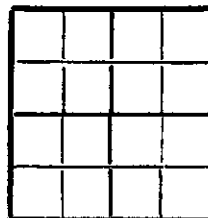8-5/8" @ 397' w/200 sax.
5 1/2" @ 4600' w/150 sax.

ELEVATION

PRODUCTION

FIGURES INDICATE BOTTOM OF FORMATIONS

RECEIVED
STATE CORPORATION COMMISSION
NOV 15 1962
CONSERVATION DIVISION
Wichita, Kansas

226	Surface soil
398	Blue shale
817	Shale & shells
1095	Shale & red bed
1320	Sand
1540	Shale & shells
1624	Shells & shale
1666	Anhydrite
1835	Shale & shells
2384	Shale & lime
2905	Lime
3045	Lime & shale, chalky
3400	Shale & lime
3625	Lime & shale
3740	Shale & lime
3809	Shale & chalky lime
4195	Lime
4330	Lime & shale
4510	Lime
4600	Lime & chert
4600	T. D.

State of KANSAS }
County of BARTON }

I, VERNE A. MORRIS of GARVEY DRILLING COMPANY
upon oath state the above and foregoing is a true and correct copy of the log of the #1 MCGINNIS well.

Subscribed and sworn to before me this 7th day of September 19 62

My Commission Expires: November 12, 1962

Verne A. Morris
Notary Public
NOTARY PUBLIC