



CONFIDENTIAL WELL COMPLETION FORM

WELL HISTORY - DESCRIPTION OF WELL & LEASE

OPERATOR: License # 34192
Name: SandRidge Exploration and Production LLC
Address 1: 123 ROBERT S. KERR AVE
Address 2: _____
City: OKLAHOMA CITY State: OK Zip: 73102 + 6406
Contact Person: Tiffany Golay
Phone: (405) 429-6543
CONTRACTOR: License # 34464
Name: Lariat Services, Inc.
Wellsite Geologist: Kathy Gentry
Purchaser: DCP Midstream, LP (gas) NCRA (oil)

Designate Type of Completion:

- New Well Re-Entry Workover
- Oil WSW SWD SLOW
- Gas D&A ENHR SIGW
- OG GSW Temp. Abd.
- CM (Coal Bed Methane)
- Cathodic Other (Core. Expl., etc.): _____

If Workover/Re-entry: Old Well Info as follows:

Operator: _____

Well Name: _____

Original Comp. Date: _____ Original Total Depth: _____

- Deepening Re-perf. Conv. to ENHR Conv. to SWD
- Conv. to GSW

Plug Back: _____ Plug Back Total Depth _____

Commingled Permit #: _____

Dual Completion Permit #: _____

SWD Permit #: _____

ENHR Permit #: _____

GSW Permit #: _____

<u>8/20/2012</u>	<u>9/12/2012</u>	<u>9/15/2012</u>
Spud Date or Recompletion Date	Date Reached TD	Completion Date or Recompletion Date

API No. 15 - 15-033-21665-01-00

Spot Description: _____

S2 S2 SW SE Sec. 30 Twp. 31 S. R. 19 East West

200 Feet from North / South Line of Section

1980 Feet from East / West Line of Section

Footages Calculated from Nearest Outside Section Corner:

- NE NW SE SW

County: Comanche

Lease Name: Larry 3119 Well #: 2-30H

Field Name: _____

Producing Formation: Mississippian

Elevation: Ground: 2136 Kelly Bushing: 2156

Total Depth: 9485 Plug Back Total Depth: _____

Amount of Surface Pipe Set and Cemented at: 1007 Feet

Multiple Stage Cementing Collar Used? Yes No

If yes, show depth set: _____ Feet

If Alternate II completion, cement circulated from: _____

feet depth to: _____ w/ _____ sx crnt.

Drilling Fluid Management Plan

(Data must be collected from the Reserve Pit)

Chloride content: 42000 ppm Fluid volume: 1605 bbls

Dewatering method used: Hauled to Disposal

Location of fluid disposal if hauled offsite: _____

Operator Name: Gray Mud Disposal

Lease Name: unnamed License #: 99999

Quarter SW Sec. 15 Twp. 24 S. R. 7 East West

County: Garfield, OK Permit #: 323003

AFFIDAVIT

I am the affiant and I hereby certify that all requirements of the statutes, rules and regulations promulgated to regulate the oil and gas industry have been fully complied with and the statements herein are complete and correct to the best of my knowledge.

Submitted Electronically

KCC Office Use ONLY

- Letter of Confidentiality Received
Date: 12/12/2012
- Confidential Release Date: _____
- Wireline Log Received
- Geologist Report Received
- UIC Distribution
- ALT I II III Approved by: NAOMI JAMES Date: 12/14/2012

Measured Depth (ft)	Sub-Sea Incl (deg)	Vertical Azim. (ft)	True Vert Depth (ft)	Northings (+) Southings (-) (ft)	Eastings (+) Westings (-) (ft)	Vert Section (ft)	DLS deg/100' (deg)	DLS			
								FNL	FSL	FWL	FEL
5898	87.90	1.20	5240.66	1123.04	4.84	1123.01	1.02	3916	1323	3094	1871
5929	88.00	0.80	5241.77	1154.01	5.38	1153.98	1.33	3885	1354	3094	1970
5960	88.30	0.60	5242.77	1184.99	5.75	1184.96	1.16	3854	1385	3094	1970
5990	88.20	0.70	5243.68	1214.98	6.10	1214.94	0.47	3824	1415	3094	1969
6021	88.10	1.00	5244.68	1245.96	6.55	1245.92	1.02	3793	1446	3094	1969
6052	88.10	1.00	5245.71	1276.94	7.10	1276.90	0.00	3762	1477	3095	1968
6083	88.80	0.40	5246.55	1307.92	7.47	1307.88	2.97	3731	1508	3095	1967
6113	89.50	0.10	5247.00	1337.92	7.60	1337.88	2.54	3701	1538	3094	1967
6144	89.50	359.90	5247.27	1368.92	7.60	1368.88	0.65	3670	1569	3094	1967
6175	89.30	359.40	5247.59	1399.91	7.42	1399.87	1.74	3639	1600	3093	1967
6206	88.70	358.70	5248.13	1430.91	6.90	1430.87	2.97	3608	1631	3092	1968
6237	88.60	358.70	5248.86	1461.89	6.20	1461.85	0.32	3577	1662	3091	1968
6267	89.50	359.00	5249.36	1491.88	5.60	1491.84	3.16	3547	1692	3090	1969
6298	90.70	359.40	5249.31	1522.87	5.16	1522.84	4.08	3516	1723	3090	1969
6329	91.40	359.50	5248.74	1553.87	4.87	1553.84	2.28	3485	1754	3089	1969
6360	91.50	359.40	5247.95	1584.86	4.57	1584.83	0.46	3454	1785	3088	1969
6391	90.80	369.20	5247.33	1615.85	4.19	1615.82	2.35	3423	1816	3087	1969
6421	90.70	369.10	5246.94	1645.84	3.75	1645.81	0.47	3393	1846	3087	1970
6452	90.20	369.20	5246.69	1676.84	3.29	1676.81	1.64	3362	1877	3086	1970
6483	90.30	368.90	5246.56	1707.83	2.77	1707.81	1.02	3331	1908	3085	1971
6514	90.40	369.00	5246.37	1738.83	2.20	1738.80	0.46	3300	1939	3084	1971
6545	89.00	369.10	5246.53	1769.82	1.69	1769.80	4.53	3269	1970	3083	1971
6575	88.70	369.10	5247.13	1799.81	1.22	1799.79	1.00	3239	2000	3082	1972
6606	88.70	369.10	5247.84	1830.80	0.73	1830.78	0.00	3208	2031	3081	1972
6637	88.00	368.50	5248.73	1861.78	0.08	1861.76	2.97	3177	2062	3080	1973
6668	88.20	368.50	5249.76	1892.75	-0.73	1892.74	0.65	3146	2093	3079	1973
6700	89.10	369.00	5250.51	1924.74	-1.43	1924.73	3.22	3114	2125	3078	1974
6732	89.50	369.60	5250.80	1956.73	-1.82	1956.72	2.25	3082	2157	3077	1974
6763	89.50	369.30	5251.17	1987.73	-2.11	1987.72	0.97	3051	2188	3077	1974
6795	90.00	369.20	5251.31	2019.72	-2.53	2019.72	1.59	3019	2220	3076	1975
6859	91.40	369.70	5250.53	2083.71	-3.15	2083.71	2.32	2855	2284	3074	1975
6955	92.20	369.80	5247.52	2179.67	-3.57	2179.66	0.84	2859	2380	3073	1975
7019	91.60	369.80	5245.39	2243.63	-3.79	2243.63	0.94	2795	2444	3072	1975
7082	90.80	369.60	5244.07	2308.61	-4.12	2308.61	1.31	2732	2507	3071	1975
7146	89.80	369.30	5243.74	2370.61	-4.73	2370.61	1.63	2668	2571	3069	1975
7210	90.10	369.10	5243.79	2434.60	-5.63	2434.61	0.56	2604	2635	3067	1976
7242	90.40	369.10	5243.66	2466.60	-6.13	2466.60	0.94	2572	2667	3067	1976
7338	90.70	369.00	5242.73	2562.58	-7.72	2562.59	0.33	2476	2763	3064	1978
7433	90.70	369.10	5241.57	2657.56	-9.30	2657.58	0.11	2381	2858	3061	1979
7529	90.90	368.60	5240.23	2753.53	-11.22	2753.56	0.56	2285	2954	3058	1980
7624	91.90	368.70	5237.91	2848.48	-13.46	2848.51	1.06	2190	3049	3054	1982
7688	90.20	368.90	5236.74	2912.46	-14.80	2912.49	2.67	2126	3113	3052	1983
7752	90.20	369.50	5236.52	2976.44	-15.69	2976.48	0.94	2062	3177	3051	1984
7816	89.30	369.60	5236.79	3040.44	-16.20	3040.48	1.41	1998	3241	3049	1984
7912	89.20	0.00	5238.05	3136.43	-16.53	3136.47	0.43	1902	3337	3048	1984
8007	90.80	0.60	5238.05	3231.43	-16.03	3231.46	1.80	1807	3432	3047	1983
8103	91.40	0.50	5235.21	3327.40	-15.11	3327.44	0.63	1711	3528	3047	1982
8198	93.80	0.50	5231.90	3422.29	-14.29	3422.32	2.53	1617	3623	3046	1981
8262	91.80	360.00	5228.77	3486.21	-14.01	3486.24	3.22	1553	3687	3046	1980
8326	88.40	0.30	5228.66	3550.20	-13.84	3550.23	5.33	1489	3751	3045	1980
8390	88.70	369.30	5230.28	3614.18	-14.06	3614.21	1.63	1425	3815	3044	1980
8453	88.80	369.00	5231.66	3677.16	-15.00	3677.19	0.50	1362	3878	3043	1980
8517	89.80	368.80	5232.44	3741.14	-16.23	3741.18	1.59	1298	3942	3040	1981
8607	87.80	368.50	5234.32	3831.09	-18.35	3831.14	2.25	1208	4031	3037	1983
8638	89.10	368.00	5235.16	3862.07	-19.29	3862.11	4.49	1177	4062	3036	1984
8701	89.80	368.50	5235.77	3925.03	-21.22	3925.09	1.37	1114	4125	3033	1986
8765	90.10	369.10	5235.82	3989.02	-22.56	3989.08	1.05	1050	4189	3031	1987
8829	91.20	369.50	5235.09	4053.01	-23.34	4053.07	1.83	986	4253	3029	1987
8893	91.80	0.10	5233.42	4116.99	-23.56	4117.05	1.33	922	4317	3028	1987

Section 19
31S 19W

Section 20
31S 19W

LARRY 1-30H
ELLIS 1-19H



309' FNL

2068' FEL

BHL: 9485'
-99.42612 37.322456

Bottom Perf: 9073'
-99.426101 37.32127

Section 30
31S 19W

Section 29
31S 19W

Top Perf: 5824'
-99.425904 37.312439

Miss Entry: 5193'
-99.425895 37.310832

LARRY 3119 2-30H



Section 31
31S 19W

Section 32
31S 19W



● Actual BH Location

* SandRidge Wells


--- Perf

□ Sections

Actual Bottom-Hole Location of Larry 3119 2-30H
Comanche County, Kansas

T&R: 31S 19W
Section: 30, 2068' FEL & 309' FNL
Long/Lat: -99.42612 37.322456

1 in = 667 ft

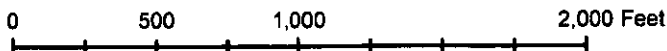

Draftsman:

Aaron Birk

Draft Date: 11/20/2012

Drawing Name/Number:

Addendum_Larry_2-30H .mxd

Coordinate System:

NAD 1927 State Plane
Kansas South FIPS: 1502