


WELL PLUGGING RECORD

Give Information Completely
Make Required Affidavit
Mail or Deliver Report to:
Conservation Division
State Corporation Commission
212 North Market, Insurance Bldg.
Wichita, Kansas

Barber County. Sec. 36 Twp. 30 Rge. (E) 12 (W)
Location as "NE/CNW/SW" or footage from lines SW - NW - SE
Lease Owner Frank J. Black
Lease Name Thom Well No. 1
Office Address McPherson, Kansas
Character of Well (completed as Oil, Gas or Dry Hole) Oil
Date well completed 1-14 19 55
Application for plugging filed 9-3 19 59
Application for plugging approved 9-8 19 59
Plugging commenced 9-7 19 59
Plugging completed 9-11 19 59
Reason for abandonment of well or producing formation Non-commercial

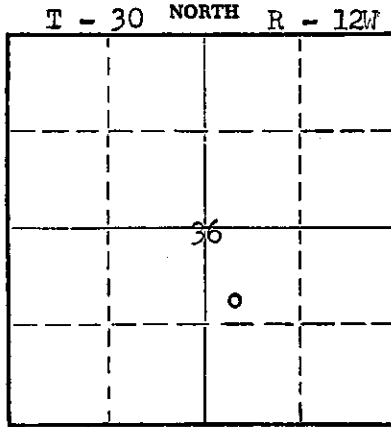

Locate well correctly on above Section Plat

If a producing well is abandoned, date of last production 19
Was permission obtained from the Conservation Division or its agents before plugging was commenced? Yes

Name of Conservation Agent who supervised plugging of this well W. L. Lac Kamp Jr.
Producing formation _____ Depth to top _____ Bottom _____ Total Depth of Well 4380 Feet
Show depth and thickness of all water, oil and gas formations.

OIL, GAS OR WATER RECORDS

CASING RECORD

FORMATION	CONTENT	FROM	TO	SIZE	PUT IN	PULLED OUT
				8 5/8	415	None
				5 1/2	4379	3736.27

Describe in detail the manner in which the well was plugged, indicating where the mud fluid was placed and the method or methods used in introducing it into the hole. If cement or other plugs were used, state the character of same and depth placed, from _____ feet to _____ feet for each plug set.

Sanded to 4360' - dumped 5 sks of cement - mudded hole to 300' - set 10' rock bridge - dumped 20 sks of cement - mudded hole to 40' set 10' rock bridge - dumped 10 sks of cement.

RECEIVED
STATE CORPORATION COMMISSION

SEP 28 1959

CONSERVATION DIVISION
Wichita, Kansas

(If additional description is necessary, use BACK of this sheet)

Name of Plugging Contractor R & D Casing Pulling Company License # 236
Address Box 569 Ellinwood, Kansas

STATE OF KANSAS, COUNTY OF MCPHERSON, ss.
Frank J. Black (owner or operator) of the above-described well, being first duly sworn on oath, says: That I have knowledge of the facts, statements, and matters herein contained and the log of the above-described well as filed and that the same are true and correct. So help me God.

(Signature) Frank J. Black

(Address)

SUBSCRIBED AND SWORN TO before me this 25th day of September, 1959

My commission expires July 16, 1963

Jerry Peltzman
JERRY PELTZMAN Notary Public.

PLUGGING

File Sec. 36 T 30 R 12W
Book Page 1 Line 45

WELL LOG BUREAU—KANSAS GEOLOGICAL SOCIETY
508 East Murdock, Wichita, Kansas

15-007-10225-0000


COPY

Company- TRANS ERA PETROLEUM, INC.
Farm- Thom No. 1

SEC. 36 T. 30 R. 12W
SW NE SE

Total Depth. 4380
Comm. 12-28-54 Comp. 1-14-55
Shot or Treated.
Contractor.
Issued. 4-2-55

County Barber KANSAS

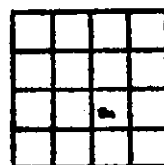

Elevation. 1701

Production. 87 bbls. oil

CASING:
8 5/8" 415' cem. w/250 sx
5 1/2" 4379' cem. w/100 sx

Figures indicate Bottom of Formations.

soil & shale	40
redbed	155
sand	205
redbed & shale	380
sand	400
redbed & shale	415
shale & shells	740
shale & sand	1040
shale & Anhydrite	1150
shale & shells	1350
salt	1440
shale & shells	1550
Anhy.	1690
shale & shells	1805
lime & shale	2050
shale & shells	2170
shale & lime	2470
shale, lime & shells	2615
shale & lime	2950
broken lime	3005
lime & shale	3440
shale	3555
sandy lime	3575
lime & shale	3615
sand & shale	3710
shale	3750
shale & sand	3791
lime	4260
lime & shale	4295
lime	4337
cherty lime	4380
Total depth	
Scout Tops:	
Heebner	3599
Douglas	3644
Brown lime	3791
Lansing	3826
Mississippi	4327

RECEIVED
STATE GEOLOGICAL COMMISSION
SEP 4 1959
CONSERVATION DIVISION
Wichita, Kansas

PLUGGING

File Sec. 36 T. 30 R. 12W

Book Page 1 Line 45