


STATE OF KANSAS
STATE CORPORATION COMMISSION

Form CP-4

Give All Information Completely
Make Required Affidavit
Mail or Deliver Report to:
Conservation Division
State Corporation Commission
212 No. Market
Wichita, Kansas

WELL PLUGGING RECORD

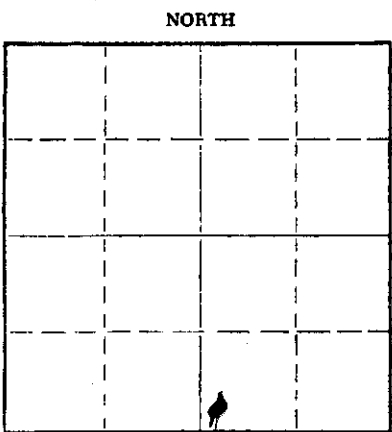

Locate well correctly on above
Section Plat

Ellsworth County. Sec. 2 Twp. 17 Rge. 9 N (E) (W)
Location as "NE/CNW/SE" or footage from lines SW SW SE
Lease Owner Specter Pipe & Supply, Company, Inc
Lease Name Becker "A" Well No. 1
Office Address Russell, Kansas
Character of Well (completed as Oil, Gas or Dry Hole) oil
Date well completed 1-25-63 19__
Application for plugging filed March 17, 1970 19__
Application for plugging approved March 19, 1970 19__
Plugging commenced April, 25, 1970 19__
Plugging completed May, 2, 1970 19__
Reason for abandonment of well or producing formation failure to produce profitably
If a producing well is abandoned, date of last production 19__
Was permission obtained from the Conservation Division or its agents before plugging was commenced? Yes

Name of Conservation Agent who supervised plugging of this well Gilbert Toman
Producing formation Arbuckle Depth to top 3242 Bottom 3244 ft. Total Depth of Well 3245 Feet
Show depth and thickness of all water, oil and gas formations.

OIL, GAS OR WATER RECORDS

CASING RECORD

| FORMATION | CONTENT | FROM | TO | SIZE | PUT IN | PULLED OUT |
|-----------|---------|------|----|-----------|----------|------------|
| | | | | 8 5/8" OD | 269 ft. | none |
| | | | | 5 1/2" OD | 3244 ft. | 2665 feet |
| | | | | | | |
| | | | | | | |
| | | | | | | |
| | | | | | | |
| | | | | | | |

Describe in detail the manner in which the well was plugged, indicating where the mud fluid was placed and the method or methods used in introducing it into the hole. If cement or other plugs were used, state the character of same and depth placed, from _____ feet to _____ feet for each plug set.

Plugged, back with sand to 3230--feet, dumped 5- sacks Cement.
Mudded hole up to 260-feet, Set a ten foot Rock Bridge.
Dumped 25- sacks Cement, Mudded hole up to 40- feet.
Set a Rock Bridge, ten sacks on top.

RECEIVED
STATE CORPORATION COMMISSION
MAY 11 1970
CONSERVATION DIVISION
Wichita, Kansas

(If additional description is necessary, use BACK of this sheet)
Name of Plugging Contractor LYNCH CASING PULLING, COMPANY, INC. NO. 457
Address R.Rt. 4 GREAT BEND, KANSAS. 67530

STATE OF Kansas COUNTY OF _____, SS.
Specter Pipe & Supply, Inc. (employee of owner) or (owner or operator) of the above-described well, being first duly sworn on oath, says: That I have knowledge of the facts, statements, and matters herein contained and the log of the above-described well as filed and that the same are true and correct. So help me God.

(Signature) [Signature]
Russell, Kansas (Address)

SUBSCRIBED AND SWORN TO before me this 16th day of April, 1970

My commission expires May 21, 1971
Melma M. Lindahl Notary Public.

15-053-19140-0000
WELL LOG BUREAU--KANSAS GEOLOGICAL SOCIETY
508 East Murdock, Wichita, Kansas


COPY

Company- MAYFIELD-SMITH DRILLING, INC., ETAL
Farm- Becker "A" No. 1

SEC. 2 T. 17 R. 9W
SW SW SE

Total Depth. 3245'
Comm. 1-17-63 Comp. 1-25-63
Shot or Treated.
Contractor.
Issued. 4-27-63

County Ellsworth
KANSAS

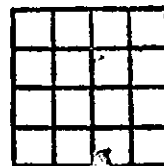

CASING:
8 5/8" 269' cem w/150 sx.
5 1/2" 3244' cem w/75 sx.

Elevation. 1819 KB

Production. 50 BOPD, 25% WTR

Figures Indicate Bottom of Formations.

| | |
|------------------------|------|
| shale | 270 |
| shale, shells & redbed | 493 |
| Anhydrite | 503 |
| shale & shells | 1752 |
| shale & lime | 2400 |
| lime | 2720 |
| lime & shale | 2785 |
| lime | 3245 |
| Total Depth | |

TOPS: SAMPLE

| | |
|------------|------|
| Anhydrite | 493 |
| Heebner | 2742 |
| Toronto | 2764 |
| Douglas | 2776 |
| Brown Lime | 2859 |
| Lansing | 2874 |
| Arbuckle | 3242 |

RECEIVED
STATE CORPORATION COMMISSION
MAR 19 1970
CONSERVATION DIVISION
Wichita, Kansas