


15-155-20531-0000

STATE OF KANSAS  
STATE CORPORATION COMMISSION

WELL PLUGGING RECORD

Give All Information Completely  
Make Required Affidavit  
Mail or Deliver Report to  
Conservation Division  
State Corporation Comm.  
245 North Water  
Wichita, KS 67202

RENO County, Sec. 35 Twp. 22 Rge. 4 E/W  
Location as "NE/CNW $\frac{1}{4}$ /SW $\frac{1}{4}$ " or footage from lines  
C SE NW SE  
Lease Owner T G T PETROLEUM CORP.  
Lease Name SCHROCK Well No. 1  
Office Address 209 E WILLIAM WICHITA, KANS. 67202  
Character of Well (Completed as Oil, Gas or Dry Hole)  
Dry Hole

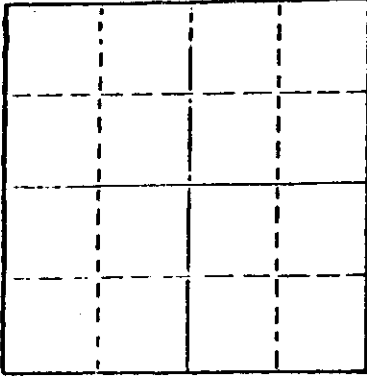

Locate well correctly on above  
Section Plat

Date Well completed 11-17 19 78  
Application for plugging filed 11-17 19 78  
Application for plugging approved 11-17 19 78  
Plugging commenced 11:15 A.M. 11-17 19 78  
Plugging completed 11:30 A.M. 11-17 19 78  
Reason for abandonment of well or producing formation

If a producing well is abandoned, date of last production 19

Was permission obtained from the Conservation Division or its agents before plugging was commenced? yes

Name of Conservation Agent who supervised plugging of this well Gilbert Toman  
Producing formation Depth to top Bottom Total Depth of Well 3888'  
Show depth and thickness of all water, oil and gas formations.

OIL, GAS OR WATER RECORDS

CASING RECORD

FORMATION	CONTENT	FROM	TO	SIZE	PUT IN	PULLED OUT

Describe in detail the manner in which the well was plugged, indicating where the mud fluid was placed and the method or methods used in introducing it into the hold. If cement or other plugs were used, state the character of same and depth placed, from feet to feet for each plug set.

Hole Full Drlg. Mud. Pumped 25 sx. cement thru drill pipe @ 700 ft.  
Plugged rat hole and water well

(If additional description is necessary, use BACK of this sheet)

Name of Plugging Contractor

STATE OF Kansas COUNTY OF Barton  
Larry Curtis (employee of owner) or (owner or operator)

of the above-described well, being first duly sworn on oath, says: That I have knowledge of the facts, statements, and matters herein contained and the log of the above-described well as filed and that the same are true and correct. So help me God.

(Signature) Larry Curtis Great Bend, Kansas 67530  
(Address)

SUBSCRIBED AND SWORN TO before me this 20th day of November, 19 78

My commission expires 5-20-81

RECEIVED  
Bessie M. Dewerff STATE NOTARY PUBLIC

BESSIE M. DEWERFF  
STATE NOTARY PUBLIC  
BARTON COUNTY, KANSAS  
MY APPT. EXP. 5-20-81

NOV 22 1978

CONSERVATION DIVISION  
Wichita, Kansas

DRILLERS WELL LOG

L. D. DRILLING COMPANY - CONTRACTOR

T G T PETROLEUM CORP. - OPERATOR

SCHROCK # 1  
C SE-NW-SE 35-22-4  
RENO COUNTY, KANSAST. D. 3888  
ELEV. 1446 K.B.COMMENCED: 11-4-78  
COMPLETED: 11-17-78CASING10-3/4" set at 261'  
8-5/8" set at 721'CEMENTW/275 sx. 60/40 Pozmix, 2% Gel, 3% CC  
W/125 sx. 60/40 Pozmix, 2% Gel, 3% CCFORMATIONShale  
Sand  
Shale  
Shale  
Shale & Lime  
Lime & Shale  
Lime  
LimeDEPTH0 - 40  
40 - 60  
60 - 260  
260 - 2150  
2150 - 2873  
2873 - 3020  
3020 - 3290  
3290 - 3888 R.T.D.TOPS


Brn. Lime	2539
Lansing	2563
Base K/C	3009
Ckr. Sn.	3148
Miss.	3310
Kinderhook	3592
Hunton	3708
Viola	3822
Simp. Shale	3841
Simp. Sand	3844

AFFIDAVITState of Kansas  
County of BartonI Larry Curtis of the L. D. DRILLING COMPANYbeing first duly sworn on oath, state: That I have knowledge of the facts.  
statements and matters herein contained and that the same are true and  
correct.

Larry Curtis  
Larry Curtis

Subscribed and sworn to before me on this 20th day of November 1978

My commission expires: 5-20-81

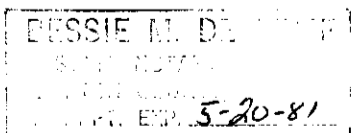

Bessie M. DeWerff  
Notary Public: Bessie M. DeWerff

RECEIVED  
STATE CORPORATION COMMISSION

NOV 22 1978

CONSERVATION DIVISION  
Wichita, Kansas