


Give All Information Completely
Make Required Affidavit
Mail or Deliver Report to:
Conservation Division
State Corporation Commission
212 North Market, Insurance Bldg.
Wichita, Kansas

15-007-011602-0000
WELL PLUGGING RECORD

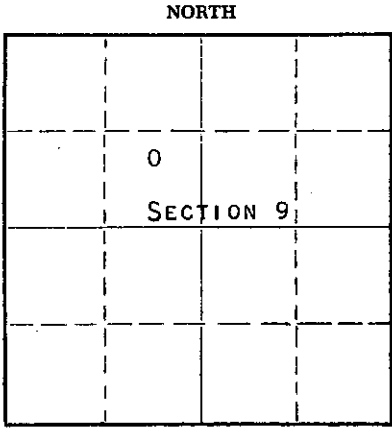

Locate well correctly on above
Section Plat

BARBER County. Sec. 9 Twp. 33S Rge. 14W (#) (W)
Location as "NE/CNW/SW" or footage from lines APPROX. NE SE NW
Lease Owner PETROLEUM, INC.
Lease Name ALLEN "D" Well No. 1
Office Address ROUTE 2, GREAT BEND, KANSAS
Character of Well (completed as Oil, Gas or Dry Hole) GAS WELL
Date well completed JULY 16 19 59
Application for plugging filed JANUARY 15 19 60
Application for plugging approved JANUARY 18 19 60
Plugging commenced JANUARY 30 19 60
Plugging completed FEBRUARY 14 19 60
Reason for abandonment of well or producing formation
COMPLETED AS A LOW MARGINABLE WELL AND NO SALES LINE AVAILABLE
If a producing well is abandoned, date of last production NONE 19
Was permission obtained from the Conservation Division or its agents before plugging was commenced? YES

Name of Conservation Agent who supervised plugging of this well FRED W. HAMPEL, PRETTY PRAIRIE, KANSAS
Producing formation MISSISSIPPI Depth to top 4680 Bottom --- Total Depth of Well 4775' Feet
Show depth and thickness of all water, oil and gas formations.

OIL, GAS OR WATER RECORDS				CASING RECORD		
FORMATION	CONTENT	FROM	TO	SIZE	PUT IN	PULLED OUT
MARMATON	WATER &	4617'	4632'	8-5/8"	1056.46'	NONE
MISSISSIPPI	LITTLE GAS	4692'	4704'	5-1/2"	4770'	3995'

Describe in detail the manner in which the well was plugged, indicating where the mud fluid was placed and the method or methods used in introducing it into the hole. If cement or other plugs were used, state the character of same and depth placed, from _____ feet to _____ feet for each plug set.

(PLUGGED BACK TO 4730.50')
FILLED HOLE WITH CRUSHED ROCK FROM 4730.50' TO 4590', FOLLOWED BY A RUBBER PLUG. PLACED 5 SACKS OF CEMENT ON TOP OF PLUG. FILLED HOLE WITH HEAVY MUD TO 300' AND BUILT SOLID ROCK BRIDGE, PLACED 20 SACKS OF CEMENT ON TOP OF SOLID ROCK BRIDGE, FILLED HOLE WITH HEAVY MUD TO 25' AND BUILT SOLID ROCK BRIDGE, FILLED HOLE TO BASE OF WELL CELLAR WITH 5 SACKS OF CEMENT.

RECEIVED
STATE CORPORATION COMMISSION
FEB 18 1960
CONSERVATION DIVISION
WICHITA, KANSAS

(If additional description is necessary, use BACK of this sheet)
Name of Plugging Contractor MORGAN WELL PLUGGING SERVICE
Address 102 WEST 18TH STREET, HUTCHINSON, KANSAS

STATE OF KANSAS, COUNTY OF BARTON, ss.
DON SEARLE (employee of owner) or (#####) of the above-described well, being first duly sworn on oath, says: That I have knowledge of the facts, statements, and matters herein contained and the log of the above-described well as filed and that the same are true and correct. So help me God.
(Signature) *Don Searle*
ROUTE 2, GREAT BEND, KANSAS
(Address)

SUBSCRIBED AND SWORN TO before me this 17TH day of FEBRUARY, 19 60
Arthur J. Wiles
Notary Public.

My commission expires APRIL 14, 1963

WELL LOG 15-007-01662-0003

COMPANY **PETROLEUM, INCORPORATED**

SEC. 9 T. 33S R. 14W

FARM **ALLEN "D" NO. 1**

LOC. Approx. NE, SE, NW


TOTAL DEPTH **4775'**

COUNTY **BARBER CO., KANSAS**

COMM. **June 6, 1958**

COMP. **June 22, 1958**

CONTRACTOR **GARVEY DRILLING COMPANY**

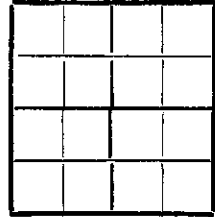

CASING **8 5/8" @ 1056.46' W/450 sax.
5 1/2" @ 4770' W/125 sax.**

ELEVATION **1798' DF**

PRODUCTION **MISSISSIPPIAN**

FIGURES INDICATE BOTTOM OF FORMATIONS

60	Surface soil, sand & shale
750	Shale & red bed
1940	Shale & shells
2002	Shale & lime
2300	Lime & shale
2410	Lime, shale & sand
2670	Lime & shale
3135	Shale & lime
3781	Lime & shale
3940	Shale & lime
4060	Shale, sand & lime
4138	Sand & shale
4620	Lime
4664	Lime & shale
4670	Lime
4715	Lime & chert
4735	Chert
4764	Chert & lime
4775	Lime
4775	T. D.

CONSERVATION DIVISION
Wichita, Kansas

State of KANSAS }
County of BARTON } ss:

I, VERNE A. MORRIS of GARVEY DRILLING COMPANY

upon oath state that the above and foregoing is a true and correct copy of the log of the #1 ALLEN "D" well

Verne A. Morris

Subscribed and sworn to before me this 6th day of August 19 58

My Commission Expires: July 11, 1960

Del. A. Brown
NOTARY PUBLIC