


15-PS-20425-0000

WELL PLUGGING RECORD

STATE OF KANSAS STATE CORPORATION COMMISSION Give All Information Completely Make Required Affidavit Mail or Deliver Report to: Conservation Division State Corporation Commission 212 North Market, Insurance Bldg. Wichita, Kansas

Trego County, Sec. 6 Twp. 11S Rge. 24W (E) (W)

Location as "NE/CNW/SW" or footage from lines SW NW NW Lease Owner Associates Oil & Gas, Inc. Lease Name Gardner Well No. 1 Office Address Suite 501, 120 S. Market, Wichita, KS 67202 Character of Well (completed as Oil, Gas or Dry Hole) Dry Hole Date well completed 8-17-77 Application for plugging filed Yes Application for plugging approved Plugging commenced Plugging completed 3:00 P.M., 8-17-77 Reason for abandonment of well or producing formation

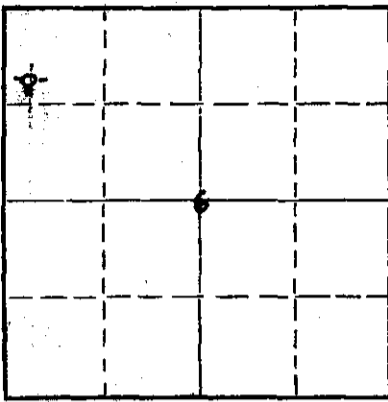

Locate well correctly on above Section Flat

If a producing well is abandoned, date of last production Was permission obtained from the Conservation Division or its agents before plugging was commenced? Yes

Name of Conservation Agent who supervised plugging of this well Gilbert Balthazor Producing formation Depth to top Bottom Total Depth of Well Feet Show depth and thickness of all water, oil and gas formations.

OIL, GAS OR WATER RECORDS

CASING RECORD

Table with 7 columns: FORMATION, CONTENT, FROM, TO, SIZE, PUT IN, PULLED OUT. The table is currently empty.

Describe in detail the manner in which the well was plugged, indicating where the mud fluid was placed and the method or methods used in introducing it into the hole. If cement or other plugs were used, state the character of same and depth placed, from feet to feet for each plug set.

Table with 3 rows of plug data: Plug #1 (950' depth, 70 SX size), Plug #2 (240' depth, 20 SX size), Plug #3 (40' depth, 10 SX size).

RECEIVED STATE CORPORATION COMMISSION

AUG 26 1977

CONSERVATION DIVISION Wichita, Kansas

Name of Plugging Contractor John O. Farmer, Inc. Address Box 352, Russell, Kansas 67665

STATE OF KANSAS, COUNTY OF RUSSELL, ss. John O. Farmer (employee of owner) or (owner or operator) of the above-described well, being first duly sworn on oath, says: That I have knowledge of the facts, statements, and matters herein contained and the log of the above-described well as filed and that the same are true and correct. So help me God.

(Signature) John O. Farmer Box 352, Russell, Kansas 67665 (Address)

SUBSCRIBED TO before me this 24th day of August, 1977

My commission expires 15, 1979

Helen Carlson Notary Public.

