


STATE OF KANSAS
STATE CORPORATION COMMISSION

WELL PLUGGING RECORD

Give All Information Completely
Make Required Affidavit
Mail or Deliver Report to:
Conservation Division
State Corporation Commission
800 Bittling Building
Wichita, Kansas

NORTH

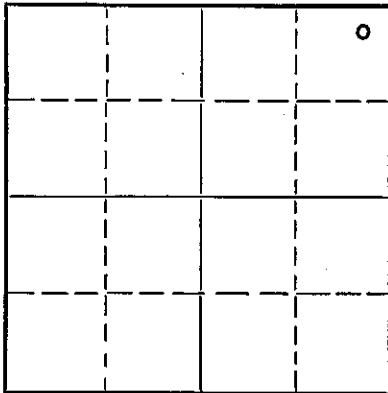

Locate well correctly on above
Section Plat

Reno

County. Sec. 32 Twp. 22S Rge. 7W (H) (W)

Location as "NE/CNW $\frac{1}{4}$ SW $\frac{1}{4}$ " or footage from lines NE NE NE

Lease Owner J. H. Johnson

Lease Name Moorman

Well No. 1

Office Address 1256 W. 71st Terrace, Kansas City, Mo.

Character of Well (completed as Oil, Gas or Dry Hole) Dry Hole

Date well completed October 14, 1951 19

Application for plugging filed October 24, 1951 19

Application for plugging approved October 25, 1951 19

Plugging commenced November 15, 1951 19

Plugging completed November 21, 1951 19

Reason for abandonment of well or producing formation Dry Hole

If a producing well is abandoned, date of last production none 19

Was permission obtained from the Conservation Division or its agents before plugging was commenced? Yes

Name of Conservation Agent who supervised plugging of this well Ruel Durkee

Producing formation none Depth to top 3937 Bottom 3951 Total Depth of Well 3951 Feet

Show depth and thickness of all water, oil and gas formations.

OIL, GAS OR WATER RECORDS

CASING RECORD

Formation	Content	From	To	Size	Put In	Pulled Out
				8-5/8"	195'	
				5-1/2"	3581'	2031'

Describe in detail the manner in which the well was plugged, indicating where the mud fluid was placed and the method or methods used in introducing it into the hole. If cement or other plugs were used, state the character of same and depth placed, from _____ feet to _____ feet for each plug set.

Plugged back from 3587 feet with sand
and six sacks of cement to 3513 feet.
Shot casing off at 2031 feet. Pulled
casing out of hole and filled hole with
heavy mud. Set permanent rock bridge
at 200 feet. Dumped in 15 sacks of
cement with bailer. Filled hole with
heavy mud to 30 feet of top. Mixed 10
sacks of cement for cap on well.

RECEIVED
STATE CORPORATION COMMISSION

FEB 18 1952

CONSERVATION DIVISION
WICHITA, KANSAS

(If additional description is necessary, use BACK of this sheet)

Name of Plugging Contractor Forbes Casing Pulling Company

Address 3315 19th, Great Bend, Kansas

STATE OF Kansas, COUNTY OF Sedgwick, ss.

(employee of owner) or (owner or operator) of the above-described well,
being first duly sworn on oath, says: That I have knowledge of the facts, statements, and matters herein contained and the log of the above-described well as filed and that the same are true and correct. So help me God.

(Signature)

J. H. Johnson
1256 W. 71st Terrace, K.C. Mo.
(Address)


SUBSCRIBED AND SWORN to before me this 18th day of February, 1952

Seaward J. Greider
Notary Public.

My commission expires Jan. 31, 1953

23-8390-s

6-51-20M

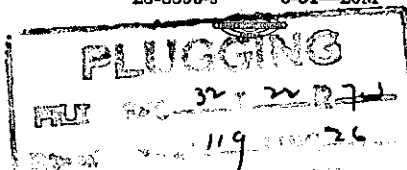

MOORMAN #1

Operator: J. H. Johnson
 Contractor: Stearns Petroleum, Inc.
 Commencement Date: September 27, 1951
 Completion Date: October 14, 1951

Location: NE/4 NE/4 NE/4
 Section 32-22-7, Reno County,
 Kansas.

Elevation: 1607 D.F.

Casing Record:

8-5/8" - 195' cemented w/190 sacks
 5-7/8" - 125' cemented w/125 sacks

Tops:
 Lansing 3045
 Mississippi 3517
 Arbuckle 3937

WELL LOG

Sand and Clay	0	120
Sandy Clay	120	187
Lime Shell	187	193
Red Bed and Shale	193	235
Shale	235	325
Red Rock and Shale	325	665
Salt, Shale and Shells	665	1005
Salt and Shale	1005	1175
Shale, Lime and Shells	1175	1220
Lime and Shale	1220	3045
Lime (Lansing)	3045	3517
Lime (Mississippi)	3517	3533
Chat and Shale	3533	3570
Lime and Shale	3570	3824
Lime	3824	3924
Sand	3924	3937
Lime (Arbuckle)	3937	3951
Total Depth	3951	

STATE OF KANSAS)
) SS
 COUNTY OF RUSSELL)

RECEIVED
 STATE OF KANSAS
 JAN 18 1952
 COUNTY OF RUSSELL

I hereby certify that the above information is true and correct to the best of my knowledge.

O. G. Stearns

Subscribed and Sworn to before me this 15th day of October, 1951.

Paul Dalton
 Notary Public

My Commission Expires: June 20, 1953.

