

STATE OF KANSAS
STATE CORPORATION COMMISSION


WELL PLUGGING RECORD

Give All Information Completely
Make Required Affidavit
Mail or Report to:
Conservation Division
State Corporation Commission
800 Bittling Building
Wichita, Kansas

OR
FORMATION PLUGGING RECORD

Strike out upper line
when reporting plug-
ging off formations.

Pawnee County. Sec. 7, Twp. 21S Rge. (E) 15 (W)
Location as "NE 1/4 NW 1/4 SW 1/4" or footage from lines. W 1/2 NW NW
Lease Owner Derby Drilling Company
Lease Name Lewis Well No. 1
Office Address 352 No. Broadway, Wichita, Kansas
Character of Well (completed as Oil, Gas or Dry Hole) Oil
Date well completed September 1 1947
Application for plugging filed December 1 1947
Application for plugging approved December 17 1947
Plugging commenced December 4 1947
Plugging completed December 21 1947
Reason for abandonment of well or producing formation Dry

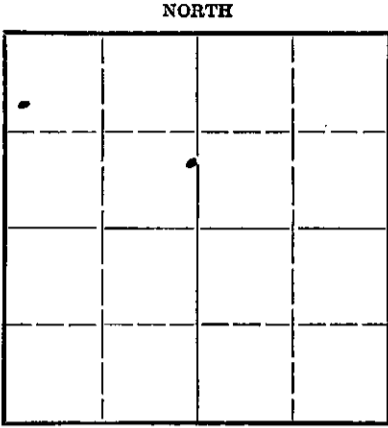

Locate well correctly on above
Section Plat

If a producing well is abandoned, date of last production No Production 19
Was permission obtained from the Conservation Division or its agents before plugging was com-
menced? Yes - from Field Representative

Name of Conservation Agent who supervised plugging of this well H. W. Kerr, Box 207, Great Bend, Kansas
Producing formation Arbuckle Depth to top 3767 Bottom 3781 Total Depth of Well 3802 Feet
Show depth and thickness of all water, oil and gas formations.


OIL, GAS OR WATER RECORDS

CASING RECORD

Formation	Content	From	To	Size	Put In	Pulled Out
Soil, gravel, shale & Red Rock	Water	0	968	8 5/8"	968	None
Lime, shale, shells			3781	5 1/2"	2772	3057

Describe in detail the manner in which the well was plugged, indicating where the mud fluid was placed and the method or methods used in introducing it into the hold. If cement or other plugs were used, state the character of same and depth placed, from _____ feet to _____ feet for each plug set.

3802 to 3779 Plastic
3779 to 3745 Cement - 5 sax
3745 to 300 Heavy Mud
300 to 170 Cement - 50 sax by Service Co.
170 to 15 Heavy Mud
15 to 6 Cement - 8 sax
6 to 0 Soil

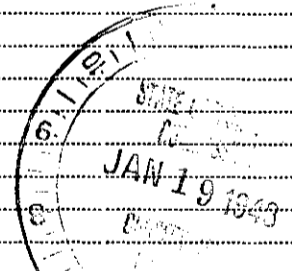

(If additional description is necessary, use BACK of this sheet)

Correspondence regarding this well should be addressed to Derby Drilling Company
Address 352 North Broadway, Wichita 2, Kansas

STATE OF Kansas, COUNTY OF Sedgwick, ss.
B. W. Durks (employee of owner) or (owner or operator) of the above-described well,
being first duly sworn on oath, says: That I have knowledge of the facts, statements, and matters herein contained and the log of the above-described well as filed and that the same are true and correct. So help me God.

(Signature) B. W. Durks

352 No. Broadway, Wichita 2, Kansas
(Address)

SUBSCRIBED AND SWORN to before me this 30th day of December, 1947.

M. A. Davis
Notary Public.

My commission expires January 5, 1952

PLUGGING
FILE REC-7 T 21 R 15W
BOOK PAGE 5 LINE 11

DERBY DRILLING COMPANY
352 North Broadway
Wichita, Kansas

Derby Drilling Company
352 No. Broadway
Wichita, Kansas

Lewis #1
CW $\frac{1}{2}$ NW NW $\frac{1}{4}$ 7-21S-15W
Pawnee County, Kansas

Spudded: August 1, 1947
Rotary completed: August 19, 1947
Cable Tool completed: September 1, 1947
Acid Treatment:
Initial Production:
Contractor: Derby Drilling Company

CASING RECORD

968: 8 5/8" 2 $\frac{1}{2}$ # Lapweld Cemented w/ 500 sacks cement.
3772: 5 1/2" 1 $\frac{1}{2}$ # E. W. Casing cemented w/ 100 sacks cement.

DRILLERS LOG

Soil & clay	0 to	25	Shale & salt	1080 to	1620
Gravel		60	Shale & shells		1890
Clay		100	Shale & lime		2071
Shale		376	Lime		2156
Sand		505	Shale		2185
Shale		550	Shale & shells		2210
Sand		560	Lime		2295
Red rock		585	Shale & lime		2757
Sand		605	Lime		3571
Red rock & Brown shale		745	Lime & shale		3680
Red Rock		957	Lime		3783
Anhydrite		1000	3783 = 3780 corrected		
Shale		1080			

STATE OF KANSAS)
) SS.
COUNTY OF SEDGWICK)

I hereby certify that to the best of my knowledge and belief, the foregoing log is true and correct.

DERBY DRILLING COMPANY

By B. W. Durks

Subscribed and sworn to before me, a Notary Public, in and for the State and County aforesaid, this 30th day of December 1947.

My commission expires ^{SV} 1-5-48

PLUGGING
FILE SEC 7 T 21 R 15 W
BOOK PAGE 5 LINE 11

Notary Public M. A. [Signature]
JAN 19 1948
1-19-48