

CARD MUST BE TYPED

State of Kansas

CARD MUST BE SIGNED

NOTICE OF INTENTION TO DRILL

(see rules on reverse side)

Starting Date 9/14/87
month day year

API Number 15- 135-23,163-0000

OPERATOR: License # 5652
Name Mustang Companies, Inc.
Address P.O. Drawer 1609
City/State/Zip Great Bend, Kansas 67530
Contact Person James Meroney
Phone (316) 792-7323

W/2 NW/4..SW/4Sec 25..... Twp..20.. S, Rg..25.... West
1980 Ft. from South Line of Section
4950 Ft. from East Line of Section

(Note: Locate well on Section Plat on reverse side)

CONTRACTOR: License # 5652
Name Mustang Companies, Inc.
City/State Great Bend, Kansas 67530

Nearest lease or unit boundary line 330 feet
County Ness
Lease Name Almqvist, Almqvist Well # 1-35
Ground surface elevation ~~2375~~ 2395 feet MSL

Well Drilled For: Well Class: Type Equipment:
 Oil SWD Infield Mud Rotary
 Gas Inj Pool Ext. Air Rotary
 OWWO Expl Wildcat Cable

Domestic well within 330 feet: yes no
Municipal well within one mile: yes no
Depth to bottom of fresh water 330
Depth to bottom of usable water ~~750~~ 780

If OWWO: old well info as follows:

Operator
Well Name
Comp Date Old Total Depth.....

Surface pipe by Alternate: 1 2
Surface pipe planned to be set ~~750~~ 800
Conductor pipe required None
Projected Total Depth 4550 feet
Formation Mississippi

I certify that well will comply with K.S.A. 55-101, et seq., plus eventually plugging hole to KCC specifications.

Date 9/14/87 Signature of Operator or Agent
Title
James Meroney


For KCC Use:

Conductor Pipe Required feet; Minimum Surface Pipe Required 800 feet per Alt.
This Authorization Expires 8-8-88 Approved By FAH 9-3-87
Effective 9-8-88

Must be filed with the K.C.C. five (5) days prior to commencing well
This card void if drilling not started within six (6) months of date received by K.C.C.

2385
770'
NE → E-SW

A Regular Section of Land
1 Mile = 5,280 Ft.

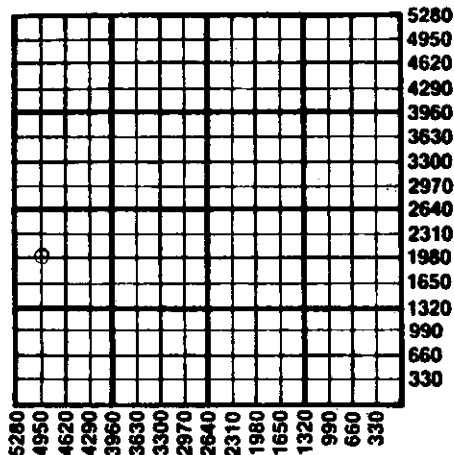

Important procedures to follow:

1. Notify District office before setting surface casing.
2. Set surface casing by circulating cement to the top.
3. File completion forms ACO-1 with K.C.C. within 90 days of well completion, following instructions on ACO-1, side 1, and including copies of wireline logs.
4. Notify District office 48 hours prior to old well workover or re-entry.
5. Prior to filing Intent, prepare a proposed plugging plan in case well is D & A, then obtain approval of plan when calling district office prior to setting surface pipe.
6. Submit plugging report (CP-4) to K.C.C. after plugging is completed.
7. Obtain an approved injection docket number before disposing of salt water.
8. Notify K.C.C. within 10 days when injection commences or terminates.
9. If an alternate 2 completion, cement in the production pipe from below any usable water to surface within 120 days of spud date.

State Corporation Commission of Kansas
Conservation Division
200 Colorado Derby Building
Wichita, Kansas 67202
(316) 263-3238