

CARD MUST BE TYPED



# NOTICE OF INTENTION TO DRILL

State of Kansas  
(see rules on reverse side)

CARD MUST BE SIGNED

Starting Date: November.....18.....1985.....  
month day year

API Number 15-053-01,012-00-01

OPERATOR: License # 6519.....

NW4 SE4 NE4 Sec 19 Twp 17 S, Rge 9  East  West  
(location)

Name C. B. Cannan.....

Address Box 453.....

City/State/Zip Pratt, Kansas 67124.....

Contact Person Same.....

Phone 672-3870.....

3640 Ft North from Southeast Corner of Section  
990 Ft West from Southeast Corner of Section  
(Note: Locate well on Section Plat on reverse side)

CONTRACTOR: License # 6901.....

Nearest lease or unit boundary line 990 feet.

Name D. S. & W. Well Servicing, Inc......

County Ellsworth.....

City/State Clafflin, Kansas.....

Lease Name Mehl Well# 7.....

Well Drilled For: Well Class: Type Equipment:

Oil  Swd  Infield  Mud Rotary

Gas  Inj  Pool Ext.  Air Rotary

OWWO  Expl  Wildcat  Cable

If OWWO: old well info as follows: X workover

Domestic well within 330 feet:  yes  no

Municipal well within one mile:  yes  no

Operator Skelly.....

Well Name Anna Mehl #1.....

Comp Date 4-18-50 Old Total Depth 3233PB2558

Projected Total Depth 2558..... feet

Projected Formation at TD Severy sand.....

Expected Producing Formations Severy sand.....

Depth to Bottom of fresh water 205..... feet

Lowest usable water formation 400..... feet

Depth to Bottom of usable water 400-320..... feet

Surface pipe by Alternate: 1  2

Surface pipe 494 set..... feet

Conductor pipe if any required..... feet

Ground surface elevation 1783' DF..... feet MSL

This Authorization Expires 5-8-86

Approved By 11-8-85 *[Signature]*

I certify that we will comply with K.S.A. 55-101, et seq., plus eventually plugging hole to K.C.C. specifications.

Date 11-7-85..... Signature of Operator or Agent


*C. B. Cannan* Title

*Owner*

Must be filed with the K.C.C. five (5) days prior to commencing well  
 This card void if drilling not started within six (6) months of date received by K.C.C.

**Important procedures to follow :**

**A Regular Section of Land  
 1 Mile = 5,280 Ft.**

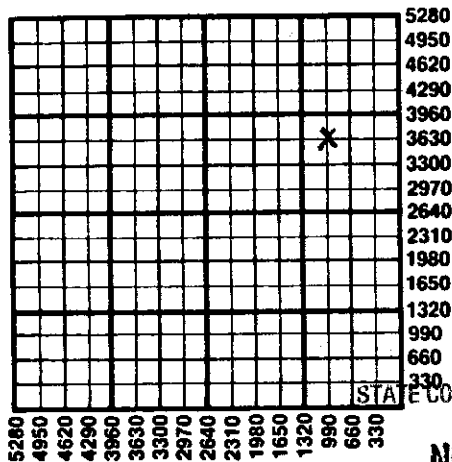

1. Notify District office before setting surface casing.
  2. Set surface casing by circulating cement to the top.
  3. File completion forms ACO-1 with K.C.C. within 90 days of well completion, following instructions on ACO-1, side 1, and including copies of wireline logs.
  4. Notify District office 48 hours prior to old well workover or re-entry.
  5. Prior to plugging, prepare a plugging plan, then obtain agreement from the appropriate district office for an approved plugging plan.
  6. Submit plugging report (CP-4) to K.C.C. after plugging is completed.
  7. Obtain an approved injection docket number before disposing of salt water.
  8. Notify K.C.C. within 10 days when injection commences or terminates.
- RECEIVED If an alternate 2 completion, cement in the production pipe from below  
 STATE CORPORATION COMMISSION water to surface within 120 days of spud date.

**NOV 8 1985**

CONSERVATION DIVISION  
 Wichita, Kansas

State Corporation Commission of Kansas  
 Conservation Division  
 200 Colorado Derby Building  
 Wichita, Kansas 67202  
 (316) 263-3238