

CARD MUST BE TYPED

State of Kansas

CARD MUST BE SIGNED

NOTICE OF INTENTION TO DRILL

(see rules on reverse side)

Collected
5-1-87

Starting Date April 5 month 1987 day year

API Number 15- 917-20,502 0000

OPERATOR: License # 7796

* NE 1/4 SW 1/4 NE 1/4 Sec. 8 Twp. 19. S, Rg. 6 East

Name Bond Oil

* 3630 Ft. from South Line of Section

Address Box 151

* 1940 Ft. from East Line of Section

City/State/Zip Marion, Ks. 66861

(Note: Locate well on Section Plat on reverse side)

Contact Person Rex Savage

Phone 316-878-4323

Nearest lease or unit boundary line 330 feet

County Chase

CONTRACTOR: License # 7796

Lease Name Pfieffer/Smith. Well # 3

Name Bond Oil

Ground surface elevation feet MSL

City/State Marion, Ks. 66861

Domestic well within 330 feet: yes no

Well Drilled For: Well Class: Type Equipment:

Municipal well within one mile: yes no

Oil SWD Infield Mud Rotary

Depth to bottom of fresh water 200 none

X Gas Inj X Pool Ext. Air Rotary

Depth to bottom of usable water 200

OWWO Expl Wildcat Cable

Surface pipe by Alternate: 1 2 X

If OWWO: old well info as follows:

Surface pipe planned to be set 50

Operator

Conductor pipe required none

Well Name

Projected Total Depth 500 feet

Comp Date Old Total Depth

Formation Indian Cave SANDSTONE

I certify that well will comply with K.S.A. 55-101, et seq., plus eventually plugging hole to KCC specifications.

Date 3-17-87 Signature of Operator or Agent

Blue Bond

Title owner

For KCC Use:

Conductor Pipe Required feet; Minimum Surface Pipe Required 50 feet per Alt. 40

This Authorization Expires 9-19-87 Approved By 3-19-87


*was SESE NE 3140 FSL
400 FEL

Must be filed with the K.C.C. five (5) days prior to commencing well
This card void if drilling not started within six (6) months of date received by K.C.C.

Important procedures to follow:

1. Notify District office before setting surface casing.
2. Set surface casing by circulating cement to the top.
3. File completion forms ACO-1 with K.C.C. within 90 days of well completion, following instructions on ACO-1, side 1, and including copies of wireline logs.
4. Notify District office 48 hours prior to old well workover or re-entry.
5. Prior to filing Intent, prepare a proposed plugging plan in case well is D & A, then obtain approval of plan when calling district office prior to setting surface pipe.
6. Submit plugging report (CP-4) to K.C.C. after plugging is completed.
7. Obtain an approved injection docket number before disposing of salt water.
8. Notify K.C.C. within 10 days when injection commences or terminates.

**A Regular Section of Land
1 Mile = 5,280 Ft.**

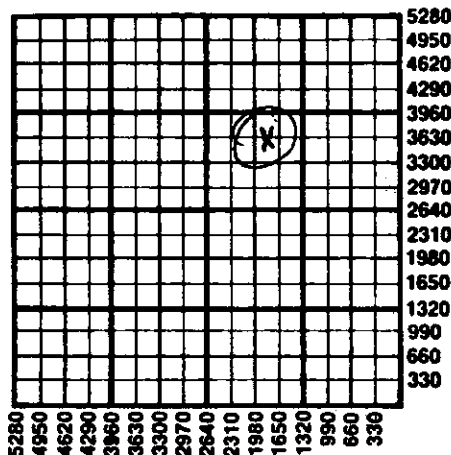

RECEIVED
STATE CORPORATION COMMISSION

MAY 1 1987
05-01-87
CONSERVATION DIVISION
Wichita, Kansas

9. If an alternate 2 completion, cement in the production pipe from
1580W any usable water to surface within 120 days of spud date.

State Corporation Commission of Kansas
Conservation Division
200 Colorado Derby Building
Wichita, Kansas 67202
(316) 263-3238