


WELL PLUGGING RECORD

Give All Information Completely
Make Required Affidavit
Mail or Deliver Report to:
Conservation Division
State Corporation Commission
800 Bitting Building
Wichita, Kansas

NORTH

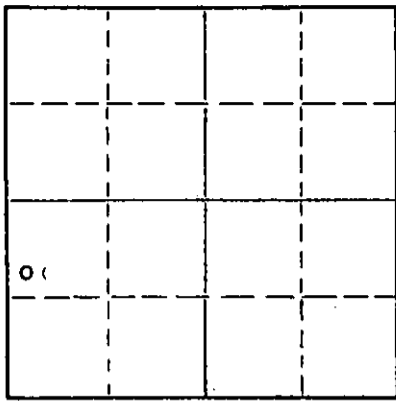

Locate well correctly on above Section Plat

Edwards County. Sec. 34 Twp. 25S Rge. (E) 20(W)
Location as "NE/CNWxSWx" or footage from lines SW NW SW
Lease Owner, Graham-Messman-Rinehart Drilling Company
Lease Name Groner Well No. 1
Office Address 1005 East Second, Wichita, Kansas
Character of Well (completed as Oil, Gas or Dry Hole) Dry hole
Date well completed May 30, 1955 19
Application for plugging filed June 10, 1955 19
Application for plugging approved June 13, 1955 19
Plugging commenced July 23, 1955 19
Plugging completed July 23, 1955 19
Reason for abandonment of well or producing formation Dry Hole

If a producing well is abandoned, date of last production 19
Was permission obtained from the Conservation Division or its agents before plugging was commenced? Yes

Name of Conservation Agent who supervised plugging of this well M. A. Rives, Pratt, Kansas
Producing formation _____ Depth to top _____ Bottom _____ Total Depth of Well 5258 Feet
Show depth and thickness of all water, oil and gas formations. (Wash down old hole - O.T.D. 5266')

OIL, GAS OR WATER RECORDS

CASING RECORD

FORMATION	CONTENT	FROM	TO	SIZE	PUT IN	PULLED OUT
				8 5/8"	498	None

Describe in detail the manner in which the well was plugged, indicating where the mud fluid was placed and the method or methods used in introducing it into the hole. If cement or other plugs were used, state the character of same and depth placed, from _____ feet to _____ feet for each plug set.

Pumped 10 sacks Jel and 125 sacks cement thru surface casing. (Approximately 250' cement in hole.) Cap welded on top.

(If additional description is necessary, use BACK of this sheet)

Name of Plugging Contractor Graham-Messman-Rinehart Oil Company (License No. 20)
Address 1005 East Second, Wichita, Kansas

STATE OF Kansas, COUNTY OF Sedgwick, ss.
Roger L. Messman (employee of owner) or (owner or operator) of the above-described well, being first duly sworn on oath, says: That I have knowledge of the facts, statements, and matters herein contained and the log of the above-described well as filed and that the same are true and correct. So help me God.

(Signature) Roger L. Messman
1005 East Second, Wichita, Kansas
(Address)

SUBSCRIBED AND SWORN to before me this 27th day of July, 19 55

My commission expires November 5, 1958

Juanita L. Lewis
Notary Public.

PLUGGING
FILE SEC 34 T 25 R 20W
BOOK PAGE 125 LINE 39

7-28-55