


STATE OF KANSAS
STATE CORPORATION COMMISSION
CONSERVATION DIVISION
P. O. BOX 17027
WICHITA, KANSAS 67217

FORM CP-4

WELL PLUGGING RECORD

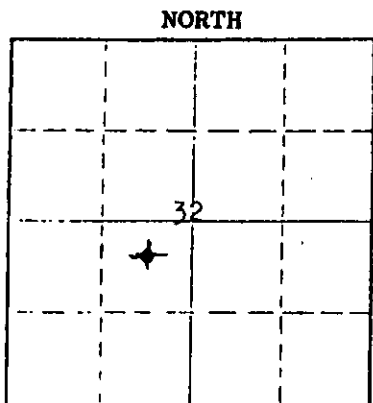

Locate well correctly on above Section Plot

Comanche County, Sec. 32 Twp. 33S Rge. 18 (E) W (W)
Location as "NE/CNW/SE/SW" or footage from lines CNESW
Lease Owner T. F. Hodge
Lease Name Rhoads Well No. 1
Office Address 2907 Ft. Worth National Bank, Ft. Worth, Tex. 76102
Character of Well (completed as Oil, Gas or Dry Hole) Dry Hole
Date well completed July 9 19 75
Application for plugging filed July 9 19 75
Application for plugging approved July 9 19 75
Plugging commenced July 10 19 75
Plugging completed July 10 19 75
Reason for abandonment of well or producing formation Dry Hole

If a producing well is abandoned, date of last production 10
Was permission obtained from the Conservation Division or its agents before plugging was commenced? Yes

Name of Conservation Agent who supervised plugging of this well Leo Massy
Producing formation _____ Depth to top _____ Bottom _____ Total Depth of Well _____ Feet
Show depth and thickness of all water, oil and gas formations.

OIL, GAS OR WATER RECORDS

CASING RECORD

FORMATION	CONTAINED	FROM	TO	SIZE	PUT IN	PULLED OUT
	RECEIVED					
	STATE CORPORATION COMMISSION			8 5/8	400	NONE
	JUL 23 1975					
	CONSERVATION DIVISION					
	Wichita, Kansas					

Describe in detail the manner in which the well was plugged, indicating where the mud fluid was placed and the method or methods used in introducing it into the hole. If cement or other plugs were used, state the character of same and depth placed, from _____ feet to _____ feet for each plug set.

Hole loaded with 9.3 lbs. per gallon 55 viscosity per second mud. Halliburton pump 35 sack cement plug from 365'-284' and 10 sack plug from 36' to 3'. Plug rat and mouse hole with 5 sacks. Cut casing off 3' below ground level and weld plate on top.

(If additional description is necessary, use BACK of this sheet)

Name of Plugging Contractor Rains and Williamson Oil Co.
Address 435 Page Court, 220 W. Douglas, Wichita, Kansas 67202

STATE OF OKLAHOMA COUNTY OF OKLAHOMA ss.
Wm. E. Ashburn

(employee of owner) or (owner or operator) of the above-described well, being first duly sworn on oath, says: That I have knowledge of the facts, statements, and matters herein contained and the log of the above-described well as filed and that the same are true and correct. So help me God.

(Signature) Wm. E. Ashburn
2601 N.W. Hwy, OKLAHOMA CITY, OK. 73112
(Address)

Subscribed and Sworn to before me this 22nd day of July 1975

My commission expires April 4, 1979

Cynthia J. Hill
Notary Public.