


STATE OF KANSAS
STATE CORPORATION COMMISSION
200 Colorado Derby Bldg.
Wichita, Kansas 67202

WELL PLUGGING RECORD

Give All Information Completely
Make Required Affidavit

COUNTY Comanche SEC. 27 TWP. 32S RGE. 18W
Location as in quarters or footage from lines: AND 1/4
Approx. NE & NW SE

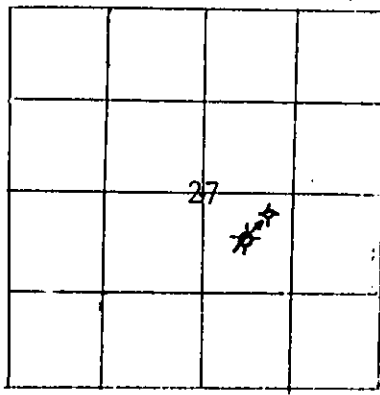

Locate Well
correctly on above
Section Platt.

Lease Owner Tomlinson Oil Co., Inc.
Lease Name Dale Well No. 1
Office Address 200 W. Douglas, Suite 1030, Wichita, KS 67202
Character of Well (Completed as Oil, Gas or Dry Hole): Dry Hole
Date Well Completed December 24, 1981
Application for plugging filed December 24, 1981
Plugging commenced December 24, 1981
Plugging completed December 24, 1981
Reason for abandonment of well or producing formation No possibility of commercial production encountered.
Was permission obtained from the Conservation Division or it's Agent's before plugging was commenced? yes

Name of Conservation Agent who supervised plugging of this well Paul Luthi, Minneola
Producing formation none Depth to top bottom T.D. 5840
Show depth and thickness of all water, oil and gas formations.

OIL, GAS OR WATER RECORDS Casing Record

Formation	Content	From	To	Size	Put in	Pulled Out
Surface Hole	shale	surface	567'	8-5/8"	564'	none
	cemented w/200 sx lite, 6%gel, 3%cc, 1/4 flocele per sx, followed w/200 sx common, 2%gel, 3%cc, cement circulated, plug down at 2:45 p.m. 12-11-81 by Halliburton.					

Describe in detail the manner in which the well was plugged, indicating where the mud fluid was placed and the method or methods used in introducing it into the hold. If cement or other plugs were used, state the character of same and depth placed, from feet to feet for each plug set.

Plugged as follows:
Filled hole w/mud, pumped 50 sx common, 2%gel, 2%CC thru open end drill pipe @ 1200'; mud to 540' plug & 35 sx, mud to 40'; 1/2 sx hulls & plug for solid bridge, 10 sx to base of cellar, 5 sx in rathole, 5 sx in mousehole, used Halliburton, complete at 6:30 p.m. 12-24-81.


RECEIVED
STATE CORPORATION COMMISSION
JAN 20 1982
CONSERVATION DIVISION
Wichita, Kansas

(If additional description is necessary, use BACK of this sheet)
Name of Plugging Contractor Husky Drilling Co., Inc.

STATE OF Kansas COUNTY OF Sedgwick, ss.
Jon T. Williams, Jr. (employee of owner) or (owner or operator) of the above-described well, being first duly sworn on oath, says: That I have knowledge of the facts, statements, and matters herein contained and the log of the above-described well as filed and that the same are true and correct. So help me God.

Husky Drilling Co., Inc.
(Signature) [Signature]
200 E. First, Suite 500, Wichita, KS 67202
(Address)

DEPOSED AND SWORN TO before me this 24th day of December, 19 81

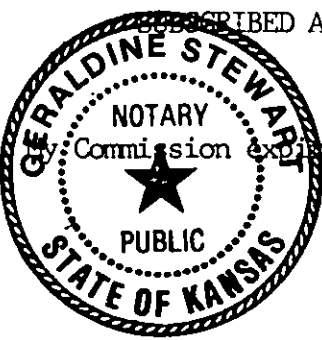

Geraldine Stewart
Geraldine Stewart Notary Public.