


WELL PLUGGING RECORD

Give All Information Completely  
Make Required Affidavit  
Mail or Deliver Report to:  
Conservation Division  
State Corporation Commission  
P. O. Box 17027  
Wichita, Kansas 67217  
NORTH

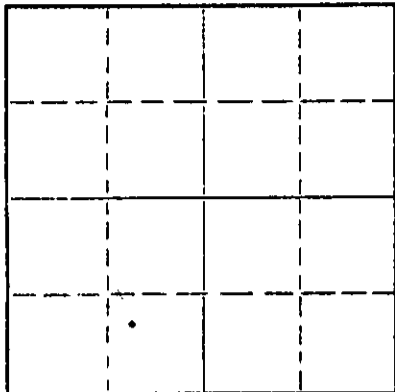

Locate well correctly on above  
Section Plat

Ellsworth County, Sec. 22 Twp. 15S Rge. 8 (E) W (W)  
Location as "NE/CNW&SW¼" or footage from lines. NW SE SW  
Lease Owner Bell Oil Company  
Lease Name Neinke Well No. 1  
Office Address 562 Wetmore Ct., Wichita, Ks.  
Character of Well (completed as Oil, Gas or Dry Hole) D&A  
Date well completed 6-3- 19 72  
Application for plugging filed 6-3- 19 72  
Application for plugging approved 6-3- 19 72  
Plugging commenced 6-3 19 72  
Plugging completed 6-3 19 72  
Reason for abandonment of well or producing formation D&A

If a producing well is abandoned, date of last production 19  
Was permission obtained from the Conservation Division or its agents before plugging was commenced? yes

Name of Conservation Agent who supervised plugging of this well Gilbert Toman  
Producing formation \_\_\_\_\_ Depth to top \_\_\_\_\_ Bottom \_\_\_\_\_ Total Depth of Well 3060 Feet  
Show depth and thickness of all water, oil and gas formations.

OIL, GAS OR WATER RECORDS

CASING RECORD

| FORMATION | CONTENT | FROM | TO | SIZE   | PUT IN | PULLED OUT |
|-----------|---------|------|----|--------|--------|------------|
|           |         |      |    | 8 5/8" | 276'   | -0-        |
|           |         |      |    |        |        |            |
|           |         |      |    |        |        |            |
Describe in detail the manner in which the well was plugged, indicating where the mud fluid was placed and the method or methods used in introducing it into the hole. If cement or other plugs were used, state the character of same and depth placed, from \_\_\_\_\_ feet to \_\_\_\_\_ feet for each plug set.

Plug hole with heavy mud to 265'  
Plug & 25 sx cement, mud 40' plug  
1/2 sx hulls, 10 sx cement

RECEIVED  
STATE CORPORATION COMMISSION  
JUN 15 1972  
CONSERVATION DIVISION  
Wichita, Kansas

(If additional description is necessary, use BACK of this sheet)

Name of Plugging Contractor Red Tiger Drilling Co.  
Address 1720 Wichita Plaza, Wichita, Ks.

STATE OF Kansas, COUNTY OF Sedgwick, ss.  
Jim Farrice (employee of owner) or (owner or operator) of the above-described well, being first duly sworn on oath, says: That I have knowledge of the facts, statements, and matters herein contained and the log of the above-described well as filed and that the same are true and correct. So help me God.

(Signature) Jim Farrice  
1720 Wichita Plaza, Wichita, Ks.  
(Address)



7-23-74

Virginia K. Albert  
Notary Public.

DRILLERS LOG

No. 1 Wellbore

CASING RECORD: COMPANY: Well Oil Company DESCRIPTION:  
 8 5/8" x 275' CONTRACTOR: Red Tiger Drilling Co. NO. 52 52  
 w/175 psi cement COMMENCED: May 30, 1972 52-122-114  
 COMPLETED: June 3, 1972 Ellsworth County,  
 Kansas

TOTAL DEPTH: 3060'

ELEVATION:

| <u>FORMATION</u> | <u>FROM</u> | <u>TO</u> | <u>REMARKS</u> |
|------------------|-------------|-----------|----------------|
| Clay & Sand      | 0           | 70        |                |
| Sand & Shale     | 70          | 277       |                |
| Shale            | 277         | 533       |                |
| Shale & Shells   | 533         | 1100      |                |
| Shale & Lime     | 1100        | 2205      |                |
| Lime             | 2205        | 2800      |                |
| Lime & Shale     | 2800        | 2900      |                |
| Lime             | 2900        | 3060      |                |


RECEIVED  

I certify that this is a true and correct copy of the above log to the best of my knowledge.

RED TIGER DRILLING COMPANY

*Jim Fawcett*  
 Jim Fawcett

Subscribed and sworn to before me this 3th day of June, 1972.

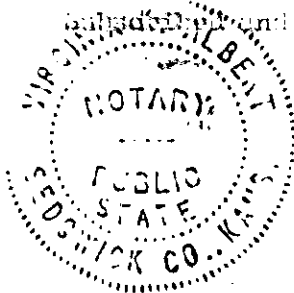

*Albert C. Beckwith*  
 Notary Public

My Commission Expires:  
7-23-74