


Give All Information Completely
Make Required Affidavit
Mail or Deliver Report to:
Conservation Division
State Corporation Commission
211 No. Broadway
Wichita, Kansas

WELL PLUGGING RECORD

Comanche County, Sec. 27 Twp. 33S Rge. 18W (88) (88)

Location as "NE/CNWxSWx" or footage from lines _____
Lease Owner Big Chief Drilling Company
Lease Name Seyfrit Well No. 1
Office Address Box 8837, Oklahoma City, Oklahoma
Character of Well (completed as Oil, Gas or Dry Hole) Dry Hole
Date well completed 26th, November, 1958 1958
Application for plugging filed 8th, December, 1958 1958
Application for plugging approved 12th, December, 1958 1958
Plugging commenced April 13th, 1959 1959
Plugging completed April 15th, 1959 1959
Reason for abandonment of well or producing formation Dry Hole

NORTH

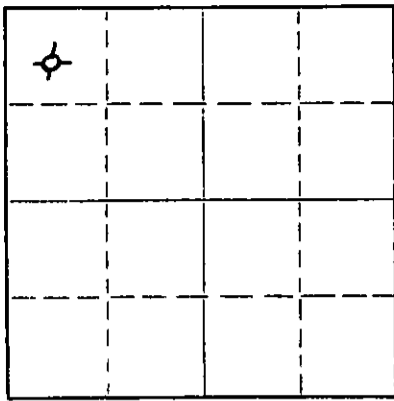

Locate well correctly on above
Section Plat

If a producing well is abandoned, date of last production None 19____
Was permission obtained from the Conservation Division or its agents before plugging was commenced? Yes

Name of Conservation Agent who supervised plugging of this well W. L. Lackamp - Stafford, Kansas
Producing formation none Depth to top _____ Bottom _____ Total Depth of Well 5,403' Feet
Show depth and thickness of all water, oil and gas formations.

OIL, GAS OR WATER RECORDS

CASING RECORD

FORMATION	CONTENT	FROM	TO	SIZE	PUT IN	PULLED OUT
				10-3/4	200'	None
				8-5/8	1302'	899'

Describe in detail the manner in which the well was plugged, indicating where the mud fluid was placed and the method or methods used in introducing it into the hole. If cement or other plugs were used, state the character of same and depth placed, from _____ feet to _____ feet for each plug set.

Rotary hole was left full of 9.6 mud when drill pipe laid down. 8-5/8" was shot off a 890' and pulled out. Hole was bailed to 400' and rock bridge 6' was placed there. 25 sacks of regular were placed from 394 to 345. Hole pumped back up to 40' and 10' rock bridge placed from 40' to 30'. 15 sacks mixed and brought up into collar.

RECEIVED
STATE CORPORATION COMMISSION

APR 18 1959

CONSERVATION DIVISION

(If additional description is necessary, use BACK of this sheet)

Name of Plugging Contractor Toland & Reeves
Address Oklahoma City, Oklahoma

STATE OF Oklahoma COUNTY OF Oklahoma, ss.
Claude Pool (employee of owner) or (owner or operator) of the above-described well, being first duly sworn on oath, says: That I have knowledge of the facts, statements, and matters herein contained and the log of the above-described well as filed and that the same are true and correct. So help me God.

(Signature) Claude Pool
Box 8837 Oklahoma City 14 Okla. (Address)

SUBSCRIBED AND SWORN TO before me this 16th day of April, 1959
Malachuk Morel

My commission expires 3-20-63 Notary Public.

PLUGGING
FILE SEC. 27 T. 33 R. 18E
BOOK PAGE 3 LINE 30

WELL RECORD

Seyfrit No. 1

NW NW Section 27-33S-18W
Comanche County, Kansas

Operator: Big Chief Drlg. Co. Date Comm: 10-31-58
Contractor: Company Tools Date Under Surf: 11-6-58
Date Completed: 11-26-58

Drillers Log

Casing & Cement Record

0 - 1300 Shale & Lime
1300 - 1430 Lime
1430 - 1550 Anhydrite
1550 - 1785 Lime & Anhydrite
1785 - 2000 Lime
2050 - 2200 Lime w/some shale
2200 - 2270 Lime
2270 - 2505 Lime w/some shale
2505 - 2830 Shale w/streaks of lime
2830 - 3380 Lime & Shale
3380 - 3430 Shale
3430 - 3520 Lime
3520 - 3575 Shale
3575 - 3835 Lime
3835 - 4110 Shale w/some sand
4110 - 4145 Lime & Shale
4145 - 4295 Sand & Shale
4295 - 4390 Lime & Shale
4390 - 4495 Sand & Shale
4495 - 4900 Lime
4900 - 4950 Shale
4950 - 5160 Lime
5160 - 5265 Lime w/shale
5265 - 5403 Solid lime
5403 Total Depth

Ran 200' 10-3/4" Lapweld pipe, cemented with 175 sx reg. w/2% cc.
Ran 1302' 8-5/8" 8 rd. 24# J-55 cemented with 100 sx reg. w/2% cc.

Acknowledged:
Big Chief Drilling Company
By: H. D. [Signature]
Date: December 8, 1958

Subscribed and sworn to before me this 8th day of December, 1958.

[Signature]
Notary Public

My commission expires: 7-9-1959

PLUGGING
FILE SEC. 27 T 33 R18W
BOOK PAGE 3 LINE 30

RECEIVED
STATE CORPORATION COMMISSION
DEC 12 1958
CONSERVATION DIVISION
Wichita, Kansas