


STATE OF KANSAS  
STATE CORPORATION COMMISSION  
Give All Information Completely  
Make Required Affidavit  
Mail or Deliver Report to:  
Conservation Division  
State Corporation Commission  
211 No. Broadway  
Wichita, Kansas

WELL PLUGGING RECORD

Comanche County, Sec. 25 Twp 33S Rge. (E) 17 (W)

Location as "NE/CNWxSWx" or footage from lines C - SE 1/4  
Lease Owner J. M. Huber Corporation  
Lease Name Warren Well No. 1  
Office Address Box 978, Liberal, Kansas  
Character of Well (completed as Oil, Gas or Dry Hole) dry hole  
Date well completed May 9 19 61  
Application for plugging filed May 9 19 61  
Application for plugging approved Rec'd permission from 5-8-61  
Plugging commenced Mr. LeKamp May 9 1961  
Plugging completed May 9 1961  
Reason for abandonment of well or producing formation dry hole

NORTH

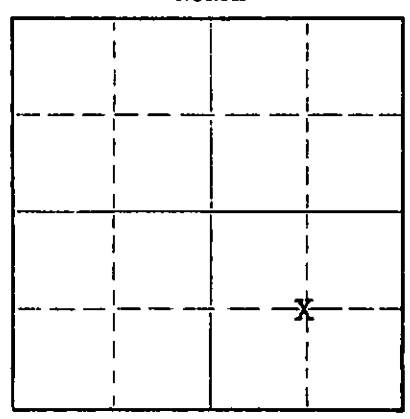

Locate well correctly on above Section Plat

If a producing well is abandoned, date of last production 19  
Was permission obtained from the Conservation Division or its agents before plugging was commenced? YES

Name of Conservation Agent who supervised plugging of this well Mr. LeKamp  
Producing formation none Depth to top Bottom Total Depth of Well 5715 Feet  
Show depth and thickness of all water, oil and gas formations.

OIL, GAS OR WATER RECORDS

CASING RECORD

FORMATION	CONTENT	FROM	TO	SIZE	PUT IN	PULLED OUT
None				13 3/8"	360'	0

Describe in detail the manner in which the well was plugged, indicating where the mud fluid was placed and the method or methods used in introducing it into the hole. If cement or other plugs were used, state the character of same and depth placed, from feet to feet for each plug set.  
Filled hole full of mud to 350'. Spotted 30 sacks cement through drill pipe at 350'. Filled rest of hole with mud and capped with 15 sacks cement as directed by Mr. Bill LeKamp, State Plugger.

RECEIVED  
STATE CORPORATION COMMISSION  
MAY 10 1961  
05-10-61  
CONSERVATION DIVISION  
Wichita, Kansas

(If additional description is necessary, use BACK of this sheet)  
Name of Plugging Contractor J. M. Huber Corporation  
Address Box 831, Borger, Texas

STATE OF Kansas COUNTY OF Seward ss.  
Floyd L. Meade (employee of owner) or (owner) of the above-described well, being first duly sworn on oath, says: That I have knowledge of the facts, statements, and matters herein contained and the log of the above-described well as filed and that the same are true and correct. So help me God.

(Signature) Floyd L. Meade  
Box 978, Liberal, Kansas (Address)

SUBSCRIBED AND SWORN TO before me this 9th day of May, 1961

Lynne M. Woods  
Notary Public.

My commission expires August 5, 1964

W E L L L O G

Well: Warren # 1  
 Operator: J. M. Huber Corporation  
 P O Box 978, Liberal, Kansas  
 Location: C-SE 1/4, Sec. 25-33S-17W  
 Commanche County, Kansas  
 Elevation: G.L. - 1,756'  
 Rig Commenced: April 19, 1961  
 Rig Completed: May 9, 1961  
 R.T.D.: 5,715'  
 Casing Record: 13-3/8" set @ 360' w/375 Sx. Common  
 plug 2 % Calcium Chloride

This well is D. & A.

Formation:

Surface soil, sand, shale, red bed	0-	360
Red bed, Gyp, shale	360-	836
Red bed, Gyp, shale, Anhydrite	836-	2,079
Lime, shale	2,079-	2,634
Lime	2,634-	2,709
Lime, shale	2,709-	3,402
Lime, shale, Chalk	3,402-	3,519
Lime, shale	3,519-	4,695
Lime, shale, Chert	4,695-	4,830
Lime, shale	4,830-	5,062
Lime, shale, Chert	5,062-	5,127
Lime, shale	5,127-	5,198
Lime, chert	5,198-	5,230
Lime, Shale	5,230-	5,387
Lime	5,387-	5,454
Lime, shale	5,454-	5,715
T.D.	5,715	

STATE OF KANSAS  
 CONSERVATION DIVISION  
 WELLS DIVISION  
 LIBERAL, KANSAS

I the undersigned, being first duly sworn upon oath, state that this well log is true and correct, according to the records of this office, and to the best of my knowledge and belief.

Floyd L. Meade  
 Floyd L. Meade  
 Petroleum Engineer

Subscribed and sworn to before me this 24<sup>th</sup>  
 day of May, 1961.

My commission expires August 5 1964

Floyd L. Meade