

STATE OF KANSAS
STATE CORPORATION COMMISSION

WELL PLUGGING RECORD

Give All Information Completely
Make Required Affidavit
Mail or Deliver Report to
Conservation Division
State Corporation Comm.
245 North Water
Wichita, KS 67202


Comanche County, Sec. 9 Twp. 33S Rge. 19 W
Location as "NE/CNW $\frac{1}{4}$ SW $\frac{1}{4}$ " or footage from lines _____
NW NE NW

Lease Owner Fitzwater Bros.
Lease Name Fitzwater Well No. 2-9
Office Address 6401 N.W. Grand Blvd., Suite 200
Oklahoma City, OK. 73116
Character of Well (Completed as Oil, Gas or Dry Hole) _____
Dry Hole

Date Well completed May 30, 1981
Application for plugging filed (Verbal) May 29, 1981
Application for plugging approved (Verbal) May 29, 1981
Plugging commenced May 30, 1981
Plugging completed May 30, 1981
Reason for abandonment of well or producing formation _____
8-5/8" csg. parted @ 114'.

If a producing well is abandoned, date of last production _____
N/A 19

Was permission obtained from the Conservation Division or its agents before plugging was commenced? Yes

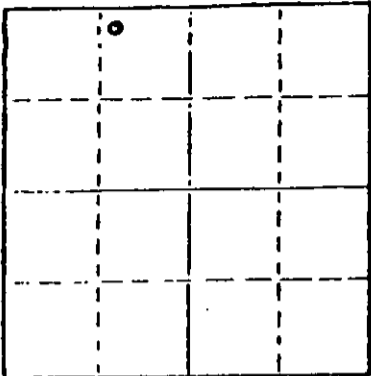

Locate well correctly on above Section Plot

Name of Conservation Agent who supervised plugging of this well _____
Producing formation None Depth to top Bottom Total Depth of Well 665'
Show depth and thickness of all water, oil and gas formations.

OIL, GAS OR WATER RECORDS

CASING RECORD

| FORMATION | CONTENT | FROM | TO | SIZE | PUT IN | PULLED OUT |
|-----------|-------------|------|-----|--------|--------|------------|
| Sand | Fresh Water | 20' | 50' | 16" | 62' | 0 |
| | | | | 8-5/8" | 643' | 3' |
| | | | | | | |
| | | | | | | |

Describe in detail the manner in which the well was plugged, indicating where the mud fluid was placed and the method or methods used in introducing it into the hold. If cement or other plugs were used, state the character of same and depth placed, from _____ feet to _____ feet for each plug set.

Plugged 8-5/8" csg. from 95' to 5' with 100 sx common cement, w/2% gel and 3% CaCl.
Cut off surface csg 3' below ground level, welded on plate.

(If additional description is necessary, use BACK of this sheet)

Name of Plugging Contractor Halliburton

RECEIVED
STATE CORPORATION COMMISSION

STATE OF Kansas COUNTY OF Comanche
R. Stanley DeLong (employee of owner)
of the above-described well, being first duly sworn on oath, says: That he has personal knowledge of the facts, statements, and matters herein contained and the log of the above-described well as filed and that the same are true and correct. So help me God.

(Signature) R. Stanley DeLong

(Address)

SUBSCRIBED AND SWORN TO before me this 5th day of June, 1981

Jane E. Honyak
Notary Public.

My commission expires Jan. 28, 1985

Verbal approval received per telephone conversation with Maurice Leslie, Kansas Corporation Commission representative.