


WELL PLUGGING RECORD

Give All Information Completely
Make Required Affidavit

COUNTY Comanche SEC. 34 TWP. 32S RGE. 19 W
Location as in quarters or footage from lines:
Center of Northwest Quarter

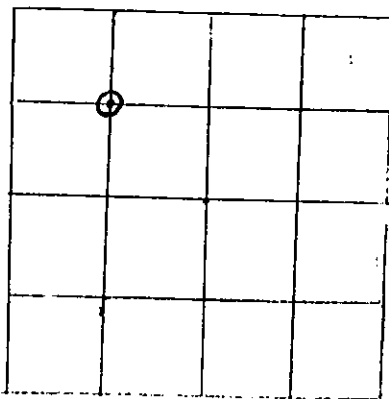

Locate Well
correctly on above
Section Platt.

Lease Owner Tuthill & Barbee
Lease Name Gillet Well No. 1-34
Office Address 300 Fisk Bldg, Amarillo, Tx 79101
Character of Well (Completed as Oil, Gas or Dry Hole): Dry
Date Well Completed 5-19-81
Application for plugging filed 4-30-82
Plugging commenced 7-23-82
Plugging completed 7-27-82
Reason for abandonment of well or producing formation Low

Production
Was permission obtained from the Conservation Division or it's
Agent's before plugging was commenced? yes

Name of Conservation Agent who supervised plugging of this well _____
Producing formation Mississippi Depth to top 5100 bottom 5220 T.D. 5220
Show depth and thickness of all water, oil and gas formations.

OIL, GAS OR WATER RECORDS

Casing Record

| Formation | Content | From | To | Size | Put in | Pulled Out |
|-------------|---------|------|------|-------|--------|------------|
| Mississippi | Gas | 5100 | 5220 | 8-5/8 | 797 | -0- |
| | | | | 4-1/2 | 5246 | 4073 |
| | | | | | | |
| | | | | | | |

Describe in detail the manner in which the well was plugged, indicating where the mud fluid was placed and the method or methods used in introducing it into the hold. If cement or other plugs were used, state the character of same and depth placed, from _____ feet to _____ feet for each plug set.

Set CIBP @ 5045'. Dumped two sacks cement on top of CIBP.
Circulated 10 ppg mud with tubing
Pumped 50 sack cement plug from 847 to 747'..
Pumped 10 sacks from 40' to 3'
Cut off head and welded on steel plate below ground.

(If additional description is necessary, use BACK of this sheet)

Name of Plugging Contractor Reeves and Wilson

STATE OF Texas COUNTY OF Potter, ss.

Dan E. Steed (employee of owner) or (~~owner or operator~~) of the above-described well, being first duly sworn on oath, says: That I have knowledge of the facts, statements, and matters herein contained and the log of the above-described well as filed and that the same are true and correct. So help me God.

(Signature) Dan E. Steed
300 Fisk Bldg, Amarillo, Tx 79101
(Address)

SUBSCRIBED AND SWORN TO before me this 20th day of August, 19 82

Alma Wilson
Notary Public.

My Commission expires: 7-25-84



ALMA WILSON
Notary Public, State of Texas
My Commission Expires July 25, 1984

RECEIVED
STATE CORPORATION COMMISSION

AUG 25 1982

CONSERVATION DIVISION
Wichita, Kansas