


STATE OF KANSAS  
STATE CORPORATION COMMISSION

Give All Information Completely  
Make Required Affidavit  
Mail or Deliver Report to:  
Conservation Division  
State Corporation Commission  
212 North Market, Insurance Bldg.  
Wichita, Kansas

WELL PLUGGING RECORD

Comanche County, Sec. 34 Twp. 32S Rge. 19 XX W (E) (W)

Location as "NE/CNW&SW" or footage from lines C NE SW  
Lease Owner Ferguson Oil Company  
Lease Name Herd Well No. 1  
Office Address 522 Union Center Bldg, Wichita, Kansas  
Character of Well (completed as Oil, Gas or Dry Hole) Dry Hole  
Date well completed August 10 1964  
Application for plugging filed August 11 1964  
Application for plugging approved August 11 1964  
Plugging commenced August 11 1964  
Plugging completed August 11 1964  
Reason for abandonment of well or producing formation

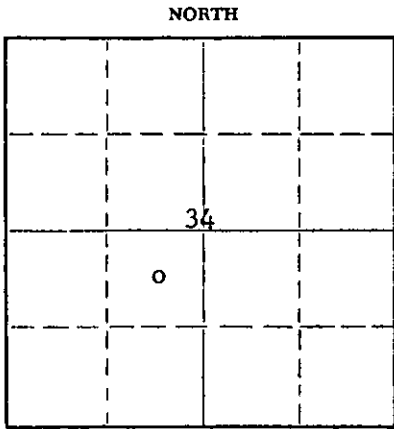

Locate well correctly on above Section Plat

If a producing well is abandoned, date of last production 19  
Was permission obtained from the Conservation Division or its agents before plugging was commenced? Yes

Name of Conservation Agent who supervised plugging of this well Archie Elving  
Producing formation Depth to top Bottom Total Depth of Well Feet  
Show depth and thickness of all water, oil and gas formations.

OIL, GAS OR WATER RECORDS

CASING RECORD

FORMATION	CONTENT	FROM	TO	SIZE	PUT IN	PULLED OUT

Describe in detail the manner in which the well was plugged, indicating where the mud fluid was placed and the method or methods used in introducing it into the hole. If cement or other plugs were used, state the character of same and depth placed, from feet to feet for each plug set.  
Heavy mud, 300', Halliburton Plug, 1/2 sack hulls and 40 sacks cement. Heavy mud, 40', Halliburton Plug, 1/2 sack hulls and 20 sacks cement back to bottom of cellar.

RECEIVED  
STATE CORPORATION COMMISSION

AUG 18 1964

CONSERVATION DIVISION  
Wichita, Kansas

(If additional description is necessary, use BACK of this sheet)

Name of Plugging Contractor D & M Drilling Co., Inc.  
Address 809 Union Center Building, Wichita, Kansas

STATE OF Kansas, COUNTY OF Sedgwick, ss.  
I, Fred S. Lillibridge (employee of owner) or (owner or operator) of the above-described well, being first duly sworn on oath, says: That I have knowledge of the facts, statements, and matters herein contained and the log of the above-described well as filed and that the same are true and correct. So help me God.

(Signature) Fred S. Lillibridge  
Ferguson Oil Company, 522 Union Center, Wichita, Kansas (Address)

SUBSCRIBED AND SWORN TO before me this 17th day of August, 1964

My commission expires September 5, 1967

Betty Welch  
Betty Welch Notary Public.

HERD NO. 1  
 C No Sw, Sec. 34-32S-19W  
 Comanche County, Kansas

Rig Up Rotary Tools 7/26/64

Ran 10 Jts. of 13 3/8" Casing. Cement w/  
 215 sacks Common w/ 27 cc and 200 sacks  
 Quick Set.

Tore Down Rotary Tools 8/11/64

<u>FORMATION</u>	<u>FROM</u>	<u>TO</u>
Red Bed & Shale	0	65'
Sand & Shale	65	150'
Shale	150	300'
Shells	300	945'
Shells w/ Lime Streaks	945	2152'
Shale	2152	2394'
Shale & Lime	2394	2675'
Lime	2675	2900'
Lime & Shale	2900	3017'
Shale	3017	3413'
Shale & Lime	3413	3818'
Shale	3818	4168'
Shale & Lime	4168	4330'
Lime	4330	5145'
Lime & Chert	5145	5163'
Lime	5163	5350' TD

KANSAS CORPORATION COMMISSION

AUG 18 1964

STATE RECORDS DIVISION  
 Topeka, Kansas

STATE OF KANSAS

COUNTY OF SEDGWICK

I, Beverly K. Wiley, do hereby certify that the foregoing is true  
 and correct to the best of my knowledge and belief.

*Beverly K. Wiley*  
 Beverly K. Wiley

Subscribed and sworn to before me this 17th day of August, 1964.

*Helen Y. Langston*  
 Helen Y. Langston, Notary Public

My Commission Expires:  
 March 26, 1967