


COPY

STATE OF KANSAS  
STATE CORPORATION COMMISSION

WELL PLUGGING RECORD

Give All Information Completely  
Make Required Affidavit  
Mail or Deliver Report to  
Conservation Division  
State Corporation Comm.  
245 North Water  
Wichita, KS 67202

Comanche County, Sec. 34 Twp. 32S Rge. 19 E/W  
Location as "NE/CNW/SW" or footage from lines

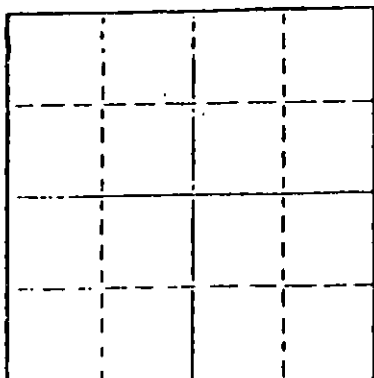

Locate well correctly on above  
Section Plat

SE SE  
Lease Owner K.R.M. PETROLEUM CORP.  
Lease Name R. W. BRASS Well No. 1  
Office Address 817 17th. St., Denver Colo. 80202  
Character of Well (Completed as Oil, Gas or Dry Hole)

Dry Hole  
Date Well completed 11-22-78 19  
Application for plugging filed 11-22-78 19  
Application for plugging approved 11-22-78 19  
Plugging commenced 11-22-78 19  
Plugging completed 11-22-78 19

Reason for abandonment of well or producing formation  
Dry Hole  
If a producing well is abandoned, date of last production 19

Was permission obtained from the Conservation Division or  
its agents before plugging was commenced? YES

Name of Conservation Agent who supervised plugging of this well Bill Owen  
Producing formation \_\_\_\_\_ Depth to top \_\_\_\_\_ Bottom \_\_\_\_\_ Total Depth of Well 6237'  
Show depth and thickness of all water, oil and gas formations.

OIL, GAS OR WATER RECORDS

CASING RECORD

FORMATION	CONTENT	FROM	TO	SIZE	PUT IN	PULLED OUT
		0	555	8 5/8"	14 jts.	

Describe in detail the manner in which the well was plugged, indicating where the mud fluid  
was placed and the method or methods used in introducing it into the hold. If cement or other  
plugs were used, state the character of same and depth placed, from \_\_\_\_\_ feet to  
\_\_\_\_\_ feet for each plug set.

50 sacks cement @560', 12 sacks @ 40' 1/2 sacks hulls  
1 wooden plug, 12 sacks cement, 3 sacks in rat hole.  
Job completed by Allied Cementing Co.

RECEIVED  
STATE CORPORATION COMMISSION

NOV 28 1978

CONSERVATION DIVISION  
Wichita, Kansas

(If additional description is necessary, use BACK of this sheet)

Name of Plugging Contractor Allied Cementing Co. Great Bend KS.

STATE OF KANSAS COUNTY OF SEDGWICK, ss.  
Wayne L. Kirkman ~~Notary Public~~ or (owner or operator)  
of the above-described well, being first duly sworn on oath, says: That I have knowledge of  
the facts, statements, and matters herein contained and the log of the above-described well  
as filed and that the same are true and correct. So help me God.

(Signature)

Wayne L. Kirkman  
453 S. Webb Rd., Wichita KS. 67207  
(Address)

SUBSCRIBED AND SWORN TO before me this 27th day of November, 19 78

Virginia Lee Smith  
Virginia Lee Smith Notary Public.

My commission expires August 25, 1980

