


STATE OF KANSAS  
STATE CORPORATION COMMISSION

Give All Information Completely  
Make Required Affidavit  
Mail or Deliver Report to:  
Conservation Division  
State Corporation Commission  
212 No. Market  
Wichita, Kansas

WELL PLUGGING RECORD

NORTH

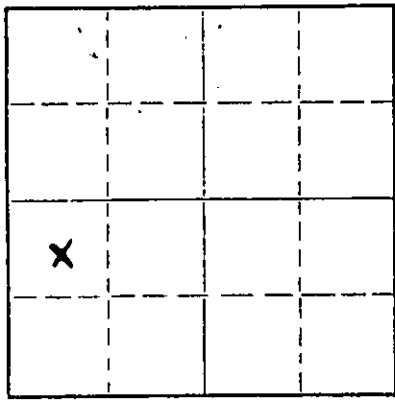

Locate well correctly on above Section Plat

Pawnee County. Sec. 6 Twp. 20 Rge. 20 (E) W (W)  
Location as "NE/CNW/SW" or footage from lines C NW SW  
Lease Owner PICKRELL DRILLING CO.; WICHITA, KANSAS  
Lease Name SCHADEL 'A' Well No. # 2  
Office Address 705 Fourth National Bank Bldg.  
Character of Well (completed as Oil, Gas or Dry Hole) Dry Hole  
Date well completed March 28 19 70  
Application for plugging filed March 26 19 70  
Application for plugging approved March 26 19 70  
Plugging commenced March 28 19 70  
Plugging completed April 25 19 70  
Reason for abandonment of well or producing formation Dry Hole

If a producing well is abandoned, date of last production \_\_\_\_\_ 19 \_\_\_\_  
Was permission obtained from the Conservation Division or its agents before plugging was commenced? Yes

Name of Conservation Agent who supervised plugging of this well Leo Massey  
Producing formation \_\_\_\_\_ Depth to top \_\_\_\_\_ Bottom \_\_\_\_\_ Total Depth of Well 4392 Feet  
Show depth and thickness of all water, oil and gas formations.

OIL, GAS OR WATER RECORDS

CASING RECORD

FORMATION	CONTENT	FROM	TO	SIZE	PUT IN	PULLED OUT
				8 5/8"	261	NONE
				5 1/2"	4385	3111
RECEIVED STATE CORPORATION COMMISSION MAY 14 1970 CONSERVATION DIVISION Wichita, Kansas						

Describe in detail the manner in which the well was plugged, indicating where the mud fluid was placed and the method or methods used in introducing it into the hole. If cement or other plugs were used, state the character of same and depth placed, from \_\_\_\_\_ feet to \_\_\_\_\_ feet for each plug set.

March 28, 1970 Plugged off bottom. Dumped sand to 4300'. Mix and dump 5 sx of cement to 4260'.

April 25, 1970 Plugged off top. Globe Oil Well Cementing Co. mixed and pumped down 8 5/8" casing: 3 sx hulls, 20 sx gel, released plug and mixed and pumped: 130 sx 50%-50% + 6% gel pozmix cement.

(If additional description is necessary, use BACK of this sheet)  
Name of Plugging Contractor RUSS CASING PULLING, INC.  
Address P. O. BOX 1082 GREAT BEND, KANSAS 67530

STATE OF Kansas, COUNTY OF Sedgwick, ss.  
Dale M. Robinson (employee of owner) or (owner or operator) of the above-described well, being first duly sworn on oath, says: That I have knowledge of the facts, statements, and matters herein contained and the log of the above-described well as filed and that the same are true and correct. So help me God.

(Signature) Dale M. Robinson  
Date M. Robinson  
705 Fourth National Bank Bldg., Wichita, Kansas  
(Address)



SUBSCRIBED AND SWORN to before me this 13th day of May, 19 70

Esther Lamone  
Notary Public.

COMPANY: Pickrell Drilling Company  
705 Fourth National Bank Bldg.  
Wichita, Kansas 67202

Rotary Drilling Commenced 3/3/70  
Rotary Drilling Completed 3/12/70

LOCATION: Schadel "A" No. 2, C NW SW Section 6-20S-20W,  
Pawnee County, Kansas

CONTRACTOR: PICKRELL DRILLING COMPANY  
Wichita, Kansas

CASING RECORD: Run 10 Jts. 8-5/8" surface casing set @ 261' KB. Cemented with 160 sacks. Completed 8:30 PM March 3, 1970. Circulated.

Ran 141 Jts. 5-1/2" casing set @ 4387'. Cemented with 125 Sacks 50-50 pozmix 6% gel & 35 sacks common. Completed 7:00 A.M. March 12, 1970.

LOG

(Figures indicate bottom of formation — measurements from top of rotary bushing.)

40	Clay & Post Rock		C.F.S.
105	Post Rock		4275
261	Shale & Shells		4340
870	Shale & Red Bed		4390
1070	Sand		4394
1436	Shale		
1477	Anhydrite		
2260	Shale		S.L.M.
2530	Shale & Lime	Strap	4080.55
2645	Lime & Shale	Board	4078.84
2885	Shale & Lime		1.71 Difference
3095	Lime & Shale		
3440	Shale & Sandy Lime		
3615	Lime & Shale		Slope Tests
3765	Shale		2000
3998	Shale & Lime		2500
4145	Lime		3000
4298	Lime & Shale		3500
4302	Lime & Shale (Pawnee)		4000
4322	Ft. Scott (Lime, etc)		
4353	Cherokee Sand		
4390	Lime & Miss.		
4394	Miss., RTD		

RECEIVED  
STATE CORPORATION COMMISSION  
MAR 27 1970  
CONSERVATION DIVISION  
Wichita, Kansas

The undersigned, C. W. Sebitts, Attorney-in-Fact for PICKRELL DRILLING COMPANY, hereby certifies in behalf of said Company, that the above is a true and correct log of the formation encountered in drilling the above well as reflected by the Daily Drilling Reports.


PICKRELL DRILLING COMPANY  
By [Signature]  
C. W. Sebitts Attorney-in-Fact

STATE OF KANSAS }  
COUNTY OF SEDGWICK }

On the 18th day of March, 19 70, before me the undersigned, a Notary Public, in and for

the State of Kansas, personally appeared C. W. Sebitts, to me known to be the person who subscribed the name of PICKRELL DRILLING COMPANY to the foregoing instrument as its authorized representative, and he acknowledged to me that he executed the same as his free and voluntary act and deed, and that he is the authorized representative of such company, for the uses and purposes therein set forth.

Witness my hand and seal of office the day and year last above written.

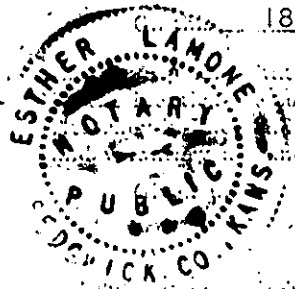

January 19, 1973

[Signature]  
Esther Lamone - Notary Public