


STATE OF KANSAS
STATE CORPORATION COMMISSION

WELL PLUGGING RECORD

Give All Information Completely
Make Required Affidavit
Mail or Deliver Report to:
Conservation Division
State Corporation Commission
211 No. Broadway
Wichita, Kansas

Kingman County. Sec. 19 Twp. 28 Rge. (E) 5 (W)
Location as "NE/CNW/SW" or footage from lines NE/4 SW/4 NW/4
Lease Owner Greenland Drilling Company
Lease Name Viney Well No. 3
Office Address 506 Union National Building, Wichita, Kansas
Character of Well (completed as Oil, Gas or Dry Hole) Oil
Date well completed 2-5-1955
Application for plugging filed 8-10-1956
Application for plugging approved 8-11-1956
Plugging commenced 9-5-1956
Plugging completed 9-8-1956
Reason for abandonment of well or producing formation Well Depleted, not commercial

NORTH

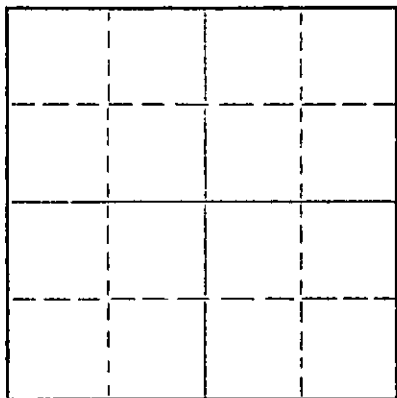

Locate well correctly on above
Section Plat

If a producing well is abandoned, date of last production Sept. 1955
Was permission obtained from the Conservation Division or its agents before plugging was commenced? Yes

Name of Conservation Agent who supervised plugging of this well M. A. Rives
Producing formation Mississippi Depth to top 3877 Bottom 3940 Total Depth of Well 3940 Feet
Show depth and thickness of all water, oil and gas formations.

OIL, GAS OR WATER RECORDS

CASING RECORD

FORMATION	CONTENT	FROM	TO	SIZE	PUT IN	PULLED OUT
				8-5/8"	156	None
				5-1/2"	3939	3138

Describe in detail the manner in which the well was plugged, indicating where the mud fluid was placed and the method or methods used in introducing it into the hole. If cement or other plugs were used, state the character of same and depth placed, from _____ feet to _____ feet for each plug set.

Measured into TD 3940'.
Plugging started 9-5-56. Finished 9-8-56.
Plugged off bottom with sand to 3860' and dumped 5 sacks cement with bailer and shot 5 1/2" casing at 3300'-3200' and 3128'. Pulled casing up to 2500' and pumped in 50 sacks aqua-gel. Pulled pipe out of hole and plugged well with heavy mud to 155' and set permanent rock bridge. Dumped 20 sacks cement. Filled hole with heavy mud to 35' and mixed 10 sacks for cap on well.

(If additional description is necessary, use BACK of this sheet)

Name of Plugging Contractor J. O. Forbes d/b/a Forbes Casing Pulling Company
Address Box 221, Great Bend, Kansas

STATE OF KANSAS, COUNTY OF SEDGWICK, ss.
Richard S. Davis, Vice-President (employee of owner) & (owner or operator) of the above-described well, being first duly sworn on oath, says: That I have knowledge of the facts, statements, and matters herein contained and the log of the above-described well as filed and that the same are true and correct. So help me God.

(Signature) [Signature]
506 Union National Building, Wichita, Kansas
(Address)

SUBSCRIBED AND SWORN TO before me this 25th day of September, 1956

Verdina B. Rutledge
Notary Public.

My commission expires March 15, 1960

PLUGGING
FILE SEC 19 T. 28. R. 5W
BOOK PAGE 89 LINE 12

10-23-56

WELL LOG

COMPANY: GREENLAND DRILLING CO.

Sec. 19 T 28S R 5W
NE SW NW
Kingman Co., Kansas

FARM: VINEY No. 3

Total Depth: 3922

Comm: 1-24-55

Comp: 2- 5-55

Contractor: Greenland Drilling Co.

Casing: 8-5/8" 156'
5-1/2" 3939'

Elevation: 1448 RB

Figures Indicate Bottom of Formations

50	Red rock & clay	TOPS:	
210	Red rock & shale		
875	Shale, shells w/ salt	Brown Lime	3024
945	Shale & lime w/salt	Lansing	3048
1355	Lime & shale	Mississippi	3877
1515	Lime w/shale breaks		
1600	Lime & shale		
1680	Shale & lime		
2000	Shale		
2540	Shale & lime		
2942	Lime & shale		
3024	Shale & lime		
3060	Sandy shale		
3159	Lime		
3390	Lime		
3515	Lime		
3722	Lime & shale		
3840	Lime & shale		
3877	Shale		
3906	Miss.		
3940	Chert		
3940	T.D.		

STATE OF KANSAS, COUNTY OF SEDGWICK, ss:

I, Richard S. Davis, Vice-President of the Greenland Drilling Co., upon oath states that the above and foregoing is a true and correct copy of the log of the Viney #3 well.

Subscribed and sworn to before me this 30th day of April, 1955.

My commission expires: March 15, 1956

Verdina B. Bullidge
Notary Public

