


STATE OF KANSAS
STATE CORPORATION COMMISSION

WELL PLUGGING RECORD

Give All Information Completely
Make Required Affidavit
Mail or Deliver Report to
Conservation Division
State Corporation Comm.
245 North Water
Wichita, KS 67202

Gray County, Sec. 9 Twp. 27S Pge. 30W ~~30W~~
Location as "NE/CNW $\frac{1}{4}$ SW $\frac{1}{4}$ " or footage from lines C SW NE

Lease Owner Olympic Petroleum Co.
Lease Name Floyd Frank Well No. 1
Office Address 2121 South Columbia, Tulsa 74114
Character of Well (Completed as Oil, Gas or Dry Hole) Dry Hole
Date Well completed 10/26/80 19
Application for plugging filed 10/26/80 19
Application for plugging approved 10/26/80 19
Plugging commenced 10/26/80 19
Plugging completed 10/26/80 4 p.m. 19
Reason for abandonment of well or producing formation _____

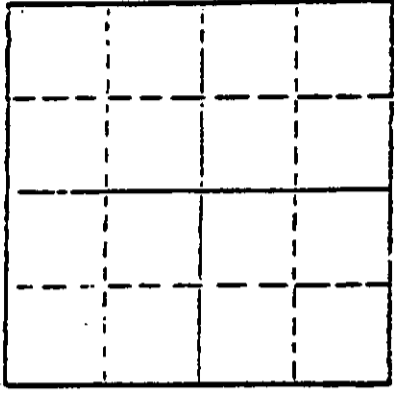

Locate well correctly on above location first

If a producing well is abandoned, date of last production _____ 19

Was permission obtained from the Conservation Division or its agents before plugging was commenced? Yes

Name of Conservation Agent who supervised plugging of this well Clarence Thomas, Jr.
Producing formation _____ Depth to top _____ Bottom _____ Total Depth of Well _____
Show depth and thickness of all water, oil and gas formations. RTD 5475'

OIL, GAS OR WATER RECORDS

CASING RECORD

FORMATION	CONTENT	FROM	TO	SIZE	PUT IN	PULLED OUT
	Surface	0	449'	8-5/8"	yes	no

Describe in detail the manner in which the well was plugged, indicating where the mud flu was placed and the method or methods used in introducing it into the hold. If cement or other plugs were used, state the character of same and depth placed, from _____ feet to _____ feet for each plug set.

1st plug @ 460' with 60 sacks
2nd plug @ 40' with 10 sacks
5 sacks in rathole
Job complete at 4 p.m. 10/26/80

RECEIVED
STATE CORPORATION COMMISSION
NOV 4 1980
NOV 11-04-80
CONSERVATION DIVISION
Wichita, Kansas

(If additional description is necessary, use BACK of this sheet)

Name of Plugging Contractor Slawson Drilling Company, Inc.

STATE OF Kansas COUNTY OF Sedgwick, ss.
James C. Remsberg, Slawson Drilling (employee of owner) or (owner or operator)

of the above-described well, being first duly sworn on oath, says: That I have knowledge of the facts, statements, and matters herein contained and the log of the above-described well is filed and that the same are true and correct. So help me God.

(Signature) James C. Remsberg
James C. Remsberg
200 Douglas Building, Wichita, Kansas 67202
(Address)

SUBSCRIBED AND SWORN TO before me this 3 day of November, 19 80

Mary Lou Taylor
Mary Lou Taylor Notary Public.

My commission expires January 17, 1981



DRILLERS LOG

OPERATOR: Olympic Petroleum Company
 2121 South Columbia
 Tulsa, Oklahoma 74114

WELL NAME: #1 Floyd Frank
 C SW NE Sec. 9-27S-30W
 Gray County, Kansas

CONTRACTOR: Slawson Drilling Company, Inc.
 200 Douglas Building
 Wichita, Kansas 67202

COMMENCED: 10/13/80

COMPLETED: 10/26/80

RTD: 5475'

SURFACE CASING: 8-5/8" set at 449' with 350 sx cement

0' to 453' Sand & Shale
 453' to 1255' Shale & Sand
 1255' to 1852' Sand & Shale
 1852' to 1885' Anhydrite
 1885' to 2375' Sand & Shale
 2375' to 3925' Lime & Shale
 3925' to 4094' Lime
 4094' to 4205' Lime & Shale
 4205' to 4249' Lime
 4249' to 4496' Lime & Shale
 4496' to 4735' Lime
 4735' to 4962' Lime & Shale
 4962' to 4992' Lime
 4992' to 5090' Lime & Shale
 5090' to 5121' Lime
 5121' to 5211' Lime & Shale
 5211' to 5388' Lime
 5388' to 5475' Lime & Shale
 RTD 5475'

RECEIVED
 STATE CORPORATION COMMISSION
 NOV - 4 1980
 CONSERVATION DIVISION
 Wichita, Kansas

STATE OF KANSAS
 COUNTY OF SEDGWICK

I, James C. Remsberg, of the Slawson Drilling Company, Inc.
 hereby state the above is an accurate copy of the Floyd Frank #1 well log
 for Olympic Petroleum Company.

James C. Remsberg

Subscribed and sworn to me this
 3rd day of November 1980

Mary Lou Taylor
 Mary Lou Taylor, Notary

My commission expires January 17, 1981

