

15-101-203110000

WELL PLUGGING RECORD

Give All Information Completely
Make Required Affidavit
Mail or Deliver Report to:
Conservation Division
State Corporation Commission
212 No. Market
Wichita, Kansas

Lane _____

County, Sec. 28 Twp. 17 Rge. 28W (E) _____ (W)

Location as "NE/CNW/SW" or footage from lines 200' E/NE SW NE

Lease Owner Donald C. Slawson

Lease Name Bryant 'B' Well No. 1

Office Address 200 Douglas Building, Wichita, Kansas 67202

Character of Well (completed as Oil, Gas or Dry Hole) dry hole

Date well completed May 4, 1978

Application for plugging filed May 4, 1978

Application for plugging approved May 4, 1978


Plugging commenced May 4, 1978

Plugging completed May 4, 1978

Reason for abandonment of well or producing formation dry hole

If a producing well is abandoned, date of last production 19

Was permission obtained from the Conservation Division or its agents before plugging was commenced? yes

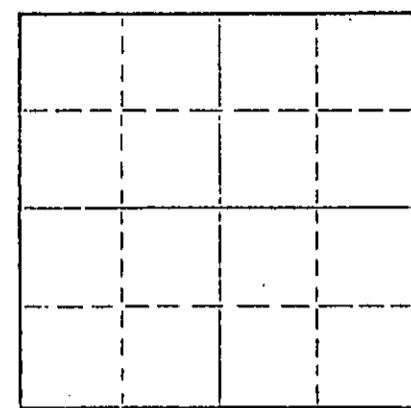

Locate well correctly on above Section Plat

Name of Conservation Agent who supervised plugging of this well Gilbert Balthazor

Producing formation _____ Depth to top _____ Bottom _____ Total Depth of Well 4585 Feet

Show depth and thickness of all water, oil and gas formations.

OIL, GAS OR WATER RECORDS

CASING RECORD

FORMATION	CONTENT	FROM	TO	SIZE	PUT IN	PULLED OUT
	283'	surface	290'	8 5/8"		

Describe in detail the manner in which the well was plugged, indicating where the mud fluid was placed and the method or methods used in introducing it into the hole. If cement or other plugs were used, state the character of same and depth placed, from _____ feet to _____ feet for each plug set.

1st plug @ 750' w/70 sx

2nd plug @ 240' w/20 sx

3rd plug @ 40' w/10 sx

2 sx in rat hole

RECEIVED
STATE CORPORATION COMMISSION
MAY 20 1978
CONSERVATION DIVISION
WICHITA, KANSAS

(If additional description is necessary, use BACK of this sheet)

Name of Plugging Contractor Slawson Drilling Co., Inc.

Address 200 Douglas Building, Wichita, Kansas 67202

STATE OF KANSAS, COUNTY OF SEDGWICK, ss.
R. J. Thatcher

(employee of owner) or (owner or operator) of the above-described well, being first duly sworn on oath, says: That I have knowledge of the facts, statements, and matters herein contained and the log of the above-described well as filed and that the same are true and correct. So help me God.

(Signature) R. J. Thatcher
R. J. Thatcher, 200 Douglas Bldg., Wichita, KS
(Address)

SUBSCRIBED AND SWORN to before me this 24th day of May, 19 78

My commission expires 10/7/79

Janet R. Tunison
Janet R. Tunison Notary Public.



WELL LOG

15-101-20311-0000

OPERATOR: Donald C. Slawson
 200 Douglas Building
 Wichita, Kansas 67202

LEASE: #1 Bryant 'B'
 200' E/NE SW NE Sec. 28-17-28W
 Lane County, Kansas

CONTRACTOR: Slawson Drilling Company, Inc.
 200 Douglas Building
 Wichita, Kansas 67202

COMMENCED: April 26, 1978

COMPLETED: May 4, 1978

CASING: Surface - 8 5/8" @ 283 w/225 sx 60/40 poz

0 - 295	Surface hole
295 - 720	Sand and shale
720 - 1635	Shale and shells
1635 - 1845	Sand
1845 - 2090	Shale and shells
2090 - 2121	Anhydrite
2121 - 2680	Shale and shells
2680 - 2890	Shale and shells w/lime streaks
2890 - 4030	Shale and lime
4030 - 4390	Lime
4390 - 4480	Shale and lime
4480 - 4585	Lime
4585	RTD

RECEIVED
 STATE CORPORATION COMMISSION
 MAY 26 1978
 CONSERVATION DIVISION
 Wichita, Kansas


STATE OF KANSAS)
) SS.
 COUNTY OF SEDGWICK)

I, R. J. Thatcher, of the Slawson Drilling Company, Inc. upon oath state that the above and foregoing is a true and correct copy of the log on the #1 Bryant 'B' test.



 R. J. Thatcher

Subscribed and sworn to before me this 24th day of May, 1978



 Janet R. Tunison, Notary Public

STATE NOTARY PUBLIC
 JANET R. TUNISON
 Sedgwick County, Ks.
 My Appmt. Exp. 10-4-79