


WELL PLUGGING RECORD

Give All Information Completely
Make Required Affidavit
Mail or Deliver Report to:
Conservation Division
State Corporation Commission

P. O. Box 17027
Wichita, Kansas 67217
NORTH

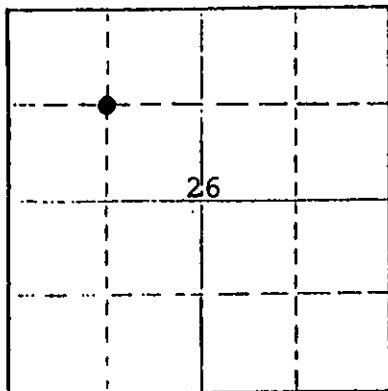

Locate well correctly on above
Section Plat

Comanche County, Sec. 26 Twp. 34S. Rge. (E) 18 (W)

Location as "NE/CNWSW" or footage from lines. C NW 1/4
Lease Owner ASCOT OILS, INC.
Lease Name Hest-Thompson (THOMPSON) Well No. 1
Office Address 980 Jordan - Shreveport, LA 71105
Character of Well (completed as Oil, Gas or Dry Hole) Dry Hole
Date well completed June 19, 1974
Application for plugging filed 19
Application for plugging approved June 24, 1974
Plugging commenced 19
Plugging completed 19
Reason for abandonment of well or producing formation

If a producing well is abandoned, date of last production 19
Was permission obtained from the Conservation Division or its agents before plugging was commenced? Yes

Name of Conservation Agent who supervised plugging of this well G. Russell Biberstein
Producing formation Depth to top Bottom Total Depth of Well 6305' Feet
Show depth and thickness of all water, oil and gas formations.

OIL, GAS OR WATER RECORDS

CASING RECORD

FORMATION	CONTENT	FROM	TO	SIZE	PUT IN	PULLED OUT
Comanche Sand	Water		60'	8 5/8"	248'	None

Describe in detail the manner in which the well was plugged, indicating where the mud fluid was placed and the method or methods used in introducing it into the hole. If cement or other plugs were used, state the character of same and depth placed, from feet to feet for each plug set.

Filled hole with mud (pumped through drill pipe) to 400'.
1st Plug placed at 400' with 40 sacks of cement
2nd Plug placed at 200' with 25 sacks of cement
3rd Plug placed at 40' with 15 sacks of cement
5 Sacks of cement placed in rat and mouse holes
Standard Bulk Cement

RECEIVED
STATE CORPORATION COMMISSION
OCT 29 1974
CONSERVATION DIVISION
Wichita, Kansas

Name of Plugging Contractor Allied Cementing Co.
Address P. O. Box 207 - Russell, Kansas 67665

STATE OF Louisiana PARISH XXXXX OF Caddo ss.
I, Keith Houser (employee of owner) or (owner or operator) of the above-described

well, being first duly sworn on oath, says: That I have knowledge of the facts, statements, and matters herein contained and the log of the above-described well as filed and that the same are true and correct. So help me God.

(Signature) Keith Houser
P.O. Box 5248 - Shreveport, LA 71105
(Address)

SUBSCRIBED AND SWORN TO before me this 24th day of October, 1974

My commission expires With Life

DOROTHY JANE SHAW, Notary Public
Caddo Parish, Louisiana
My Commission Is For Life