

STATE OF KANSAS  
STATE CORPORATION COMMISSION

WELL PLUGGING RECORD

Give All Information Completely  
Make Required Affidavit  
Mail or Deliver Report to  
Conservation Division  
State Corporation Comm.  
245 North Water  
Wichita, KS 67202


Comanche County, Sec. 19 Twp. 34 Rge. 17 XX/W  
Location as "NE/CNW $\frac{1}{4}$ SW $\frac{1}{4}$ " or footage from lines  
C NE SE

Lease Owner George R. Jones  
Lease Name Haas Well No. 3  
Office Address 125 N. Market, Suite 1210, Wichita, KS 67202  
Character of Well (Completed as Oil, Gas or Dry Hole) \_\_\_\_\_  
dry hole

Date Well completed August 31, 1983 19  
Application for plugging filed Aug. 30, 1983 (verbal) 19  
Application for plugging approved Yes 19  
Plugging commenced August 30, 1983 19  
Plugging completed August 31, 1983 19  
Reason for abandonment of well or producing formation \_\_\_\_\_  
dry hole

If a producing well is abandoned, date of last production \_\_\_\_\_  
19

Was permission obtained from the Conservation Division or  
its agents before plugging was commenced? Yes

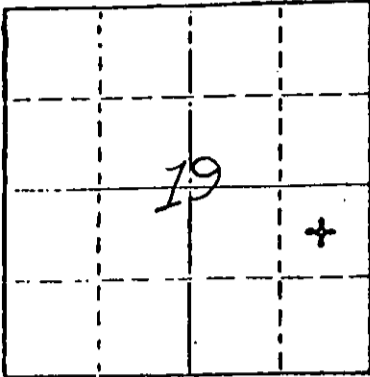

Locate well correctly on above  
Section Plat

Name of Conservation Agent who supervised plugging of this well Richard Lacey  
Producing formation \_\_\_\_\_ Depth to top \_\_\_\_\_ Bottom \_\_\_\_\_ Total Depth of Well \_\_\_\_\_  
Show depth and thickness of all water, oil and gas formations.

OIL, GAS OR WATER RECORDS

CASING RECORD

FORMATION	CONTENT	FROM	TO	SIZE	PUT IN	PULLED OUT
		13 jts	24# 8-5/8"	set at	519'	cemented with
		225 sx	Light, 3% c.c.;	100 sx	Common, 2% gel,	
			3% c.c.; cement	did not	circulate;	1" topped
		60' 50	sx	Common.		

Describe in detail the manner in which the well was plugged, indicating where the mud fluid  
was placed and the method or methods used in introducing it into the hold. If cement or other  
plugs were used, state the character of same and depth placed, from \_\_\_\_\_ feet to  
\_\_\_\_\_ feet for each plug set.

60-40 Posmix, 2% gel, 3% c.c.  
50 sx @ 840'  
40 sx @ 540'  
10 sx @ 40'  
15 sx in mousehole  
15 sx in rathole  
PD @ 2:30 a.m. 8/31/83 by Halliburton

(If additional description is necessary, use BACK of this sheet)

Name of Plugging Contractor Halliburton Services

STATE OF KANSAS COUNTY OF SEDGWICK, ss.  
George R. Jones (employee of owner) or (owner or operator)  
of the above-described well, being first duly sworn on oath, says: That I have knowledge of  
the facts, statements, and matters herein contained and the log of the above-described well  
as filed and that the same are true and correct. So help me God.

(Signature) [Signature]  
125 N. Market, Suite 1210, Wichita, KS 67202  
(Address)

SUBSCRIBED AND SWORN TO before me this 31st day of August, 1983

[Signature]  
Notary Public.

My commission expires August 5, 1984

RECEIVED  
STATE CORPORATION COMMISSION

SFP 1 1983

CONSERVATION DIVISION  
Wichita, Kansas

WILMA E. CLARK  
NOTARY PUBLIC  
State of Kansas  
My Appt. Exp. Aug. 5, 1984