


STATE OF KANSAS
STATE CORPORATION COMMISSION

WELL PLUGGING RECORD

Give All Information Completely
Make Required Affidavit
Mail or Deliver Report to
Conservation Division
State Corporation Comm.
245 North Water
Wichita, KS 67202

Comanche County, Sec. 13 Twp. 34 Rge. 18W E/W
Location as "NE/CNW 1/4 SW 1/4" or footage from lines 220' S. of
NW SE SE

Lease Owner George R. Jones
Lease Name Wolf Well No. 1
Office Address Suite 1310, 125 No. Market, Wichita, KS 67202
Character of Well (Completed as Oil, Gas or Dry Hole) dry hole

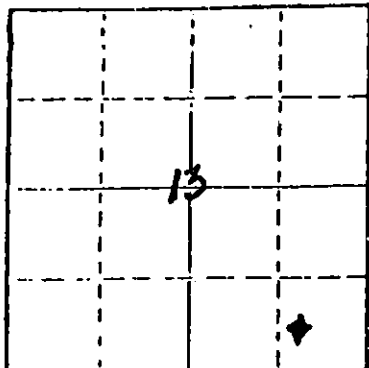

Locate well correctly on above
Section Plat

Date Well completed November 3, 1980 19
Application for plugging filed verbal application 19
Application for plugging approved verbal approval 19
Plugging commenced November 3, 1980 19
Plugging completed November 3, 1980 19
Reason for abandonment of well or producing formation dry hole

If a producing well is abandoned, date of last production 19

Was permission obtained from the Conservation Division or its agents before plugging was commenced? Yes

Name of Conservation Agent who supervised plugging of this well Clarence Thomas, Jr.
Producing formation Depth to top Bottom Total Depth of Well 5290'
Show depth and thickness of all water, oil and gas formations. RTD

OIL, GAS OR WATER RECORDS

CASING RECORD

FORMATION	CONTENT	FROM	TO	SIZE	PUT IN	PULLED OUT
		Ran 14 jts of new		24# 8-5/8" (440' overall);		
		cemented with 325 sacks Common, 2% gel, 3% c.c.		cement circulated by Halliburton.		
		PD 11:45 p.m. 10/21/80				

Describe in detail the manner in which the well was plugged, indicating where the mud fluid was placed and the method or methods used in introducing it into the hold. If cement or other plugs were used, state the character of same and depth placed, from feet to feet for each plug set.

1st plug @ 460' w/60 sacks;
2nd plug @ 40' w/10 sacks;
5 sacks in rathole.
PD 8:00 p.m. 11/3/80

(If additional description is necessary, use BACK of this sheet)

Name of Plugging Contractor Halliburton Services, Inc.

RECEIVED
STATE CORPORATION COMMISSION
NOV 26 1980
CONSERVATION DIVISION
Wichita, Kansas

STATE OF KANSAS COUNTY OF SEDGWICK

George R. Jones (employee of owner) or (owner or operator)


of the above-described well, being first duly sworn on oath, says: That I have knowledge of the facts, statements, and matters herein contained and the log of the above-described well as filed and that the same are true and correct. So help me God.

(Signature) George R. Jones
Suite 1310, 125 No. Market, Wichita, KS 67202
(Address)

SUBSCRIBED AND SWORN TO before me this 25th day of November, 19 80

Wilma E. Clark
Notary Public.

My commission expires August 5, 1984

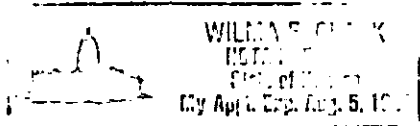

GABBERT-JONES, INC.
WICHITA, KANSAS
DRILLERS' WELL LOG

Wolf #1
NW-SE-SE Sec 13-34S-18W
Comanche County Kansas

Commenced: 10-21-80

Completed: 11-3-80

OPERATOR George R. Jones

Eppeth		Formation	Remarks
From	To		
0	450	Redbed	Ran 14 jts of 24# 8 5/8" csg set @ 446' Cemented w/325 sks Common 2% Gel 3% CC PD @ 11:45 p.m. 10-21-80
450	1713	Redbed-Shale	
1713	2030	Shale	
2030	2260	Shale-Lime	
2260	2645	Lime-Shale	
2645	2775	Shale-Lime	
2775	2928	Lime-Shale	
2928	3260	Shale-Lime	
3260	3420	Lime-Shale	
3420	3760	Shale-Lime	
3760	4335	Limes-Shale	
4335	5163	Lime	
5163	5230	Shale-Lime	
5230	5290	Lime-Shale	
	5290 - TD		DRY & ABANDONED

STATE OF KANSAS)
) SS
COUNTY OF SEDGWICK)

I, the undersigned, being duly sworn on oath, state that the above Drillers' Well Log is true and correct to the best of my knowledge and belief and according to the records of this office.

GABBERT-JONES, INC.

James S. Sutton II
JAMES S. SUTTON II

Subscribed and sworn to before me this 10th day of November, 1980.

Elizabeth J. Edwards
ELIZABETH J. EDWARDS-NOTARY PUBLIC

My Commission expires February 6, 1983.

RECEIVED
STATE CORPORATION COMMISSION
NOV 26 1980
CONSERVATION DIVISION
Wichita, Kansas

