


STATE OF KANSAS
STATE CORPORATION COMMISSION

WELL PLUGGING RECORD

Give All Information Completely
Make Required Affidavit
Mail or Deliver Report to:
Conservation Division
State Corporation Commission
800 Bitting Building
Wichita, Kansas

Comanche County, Sec. 38 Twp. 34 Rge. (E) 17 (W)
Location as "NE/CNWSW" or footage from lines NW NW NW
Lease Owner Graham-Messman-Rinehart Drilling Company
Lease Name Jackson Well No. 1
Office Address 1005 East Second, Wichita, Kansas
Character of Well (completed as Oil, Gas or Dry Hole) Dry Hole
Date well completed August 16, 1954 19
Application for plugging filed August 13, 1954 19
Application for plugging approved August 11, 1954 19
Plugging commenced August 22, 1954 19
Plugging completed August 23, 1954 19
Reason for abandonment of well or producing formation Dry Hole

NORTH

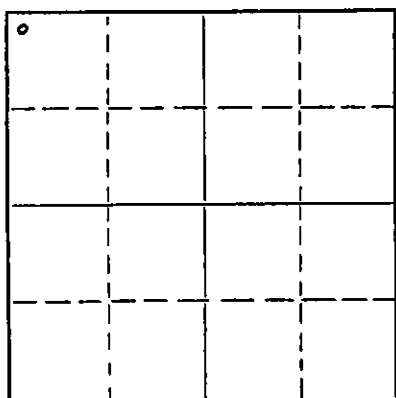

Locate well correctly on above
Section Plat

If a producing well is abandoned, date of last production - 19
Was permission obtained from the Conservation Division or its agents before plugging was commenced? Yes

Name of Conservation Agent who supervised plugging of this well Merle Rives
Producing formation - Depth to top - Bottom - Total Depth of Well 6500 Feet
Show depth and thickness of all water, oil and gas formations.

OIL, GAS OR WATER RECORDS

CASING RECORD

FORMATION	CONTENT	FROM	TO	SIZE	PUT IN	PULLED OUT
				13 3/8"	231'	None
				8 5/8"	2360'	

Describe in detail the manner in which the well was plugged, indicating where the mud fluid was placed and the method or methods used in introducing it into the hole. If cement or other plugs were used, state the character of same and depth placed, from _____ feet to _____ feet for each plug set.

Filled hole with mud to 450', set rock bridge, dumped 25 sax cement. Top of cement, 420'. Filled with mud to 20', set rock bridge, dumped 15 sax for cap.

(If additional description is necessary, use BACK of this sheet)

Name of Plugging Contractor Miller Casing Pulling Company
Address P. O. Box 711, Great Bend, Kansas

STATE OF Kansas, COUNTY OF Sedgwick, ^{sp} Partner
Roger L. Messman (employee of owner) or (owner or operator) of the above-described well, being first duly sworn on oath, says: That I have knowledge of the facts, statements, and matters herein contained and the log of the above-described well as filed and that the same are true and correct. So help me God.

(Signature) Roger L. Messman
1005 East Second, Wichita, Kansas
(Address)

SUBSCRIBED AND SWORN TO before me this 31st day of August, 19 54

Betty Janet Palford
Notary Public.

My commission expires September 14, 1957

24-7308-B 3-53-20M

CORPORATION COMMISSION

SEP - 1 1954

CONSERVATION DIVISION
Wichita, Kansas

PLUGGING
FILE SEC 28 T 34 R 17W
BOOK PAGE 64 LINE 26

NO. 1 JACKSON

WELL RECORD

Location: NW NW NW 28-34S-17W
Comanche County, Kansas

Operator: Graham-Messman-Rinehart Oil Company
1005 E. 2nd St., Wichita, Kansas

Contractor: Graham-Messman-Rinehart Drlg. Company
1005 E. 2nd St., Wichita, Kansas

Casing Record: 13 3/8" @ 231' w/150 sacks cement
8 5/8" @ 2360 w/125 sacks cement

Commenced: May 28, 1954

Completed: August 6, 1954

Elevation: 1812 K.B.

Production: D & A

.....L O G.....

Clay	15
Lime	73
Gyp	150
Gyp	231
Shale	870
Lime - shale	1155
Shale	1590
Lime - shale	2190
Anhydrite	2250
Lime - shale	2706
Shale - lime	2815
Lime - shale	3610
Shale - sand	3640
Lime - shale	3880
Shale	4035
Shale - lime	4225
Shale	4325
Lime - shale	4409
Shale - sand	4450
Lime - shale	4535
Shale	4590
Lime - shale	5240
Lime	5270
Lime - shale	5478
Cherty lime	5524
Lime	5570
Lime - shale	6140
Coring	6204
Lime - shale	6263
Shale - sand	6277
Lime - shale	6447
Lime	6500 R.T.D.

Elgin Sand 4116' (-2334)

Toronto 4310' (-2498)

Douglas Sand 4381' (-2569)

Lansing 4500' (-2688)

Base Kansas City 4856' (-3044)

Marmaton 4936' (-3124)

Mississippi 5241' (-3429)

Warsaw 5522' (-3710)

Kinderhook 5820' (-4008)

Viola 5906' (-4094)

Simpson 6104' (-4292)

Arbuckle 6294' (-4482)

The undersigned, GRAHAM-MESSMAN-RINEHART DRILLING COMPANY, hereby certifies that the above log is a true and correct log of the formation encountered in drilling the above well as reflected by the Daily Drilling Report.

GRAHAM-MESSMAN-RINEHART DRILLING COMPANY

By: J. A. Gilliland
J. A. Gilliland

Subscribed and sworn to before me this 12th day of August, 1954.

Notary Public

My Commission Expires: September 14, 1957

PLUGGING
FILE SEC 28 T 34 R 17N
BOOK PAGE 56 LINE 26

RECEIVED
STATE CORPORATION COMMISSION
CONSERVATION DIVISION
Wichita, Kansas