

1051899
To: STATE CORPORATION COMMISSION
CONSERVATION DIVISION - PLUGGING SECTION
200 COLORADO DERBY BUILDING
WICHITA, KANSAS 67202

2-15
API NUMBER 15-055-21,377 0000
E/2 SE SW, SEC. 13, T 23 S, R 31 W/E
660 feet from S section line
2970 feet from E section line

TECHNICIAN'S PLUGGING REPORT

Operator License # 5123
Operator: Pickrell Drilling Company, Inc.
Name & Address: 110 N. Market, Ste. 205
Wichita, KS 67202

Lease Name Wells T _____ Well # 1
County Finney
Well Total Depth 4950 ^{160'} feet
Conductor Pipe: Size _____ feet
Surface Casing: Size 8 5/8 feet 482

Abandoned Oil Well Gas Well _____ Input Well _____ SWD Well _____ D&A _____
Other well as hereinafter indicated _____

Plugging Contractor Mike's Testing & Salvage, Inc. License Number 31529
Address P.O. Box 209, Chase, KS 67524-0209

Company to plug at: Hour: 1 p.m. Day: 15 Month: 2 Year: 1995

Plugging proposal received from Vernon Duntz Jr.

(company name) Mike's Testing & Salvage, Inc. (phone) 816-938-2943

were: 4 1/2" at 4946' w/200 sx cement, PRTD 4912', Perfs at 4866-71'
1st plug sand back to 4800' and dump 4 sx cement on top of sand through bailer,
2nd plug pump 80 sx cement at 1260',
3rd plug pump 50 sx cement at 510',
4th plug pump 10 sx cement at 40'.

Plugging Proposal Received by Richard Lacey
(TECHNICIAN)

Plugging Operations attended by Agent?: All Part _____ None _____

Operations Completed: Hour: 3:50 p.m. Day: 15 Month: 2 Year: 1995

ACTUAL PLUGGING REPORT 1st plug sanded back to 4800' and dumped 4 sx cement on top of sand through bailer,
2nd plug at 1260' with 80 sx cement,
3rd plug at 510' with 50 sx cement,
4th plug at 40' with 10 sx cement.

STATE CORPORATION COMMISSION
FEB 17 1995


Remarks: Used 60/40 Pozmix 6% gel by Allied. Recovered 1500' of 4 1/2" casing.
(If additional description is necessary, use BACK of this form.)

INVOICED
DATE 2-24-95
WV. NO. 42264

Signed Richard M. Lacey
(TECHNICIAN)

New Completion Workover

Oil Company _____ Well No. 1 Field _____ Lease Wells T
Company Man _____ Date Drilled 1/95 County Finney State Kansas

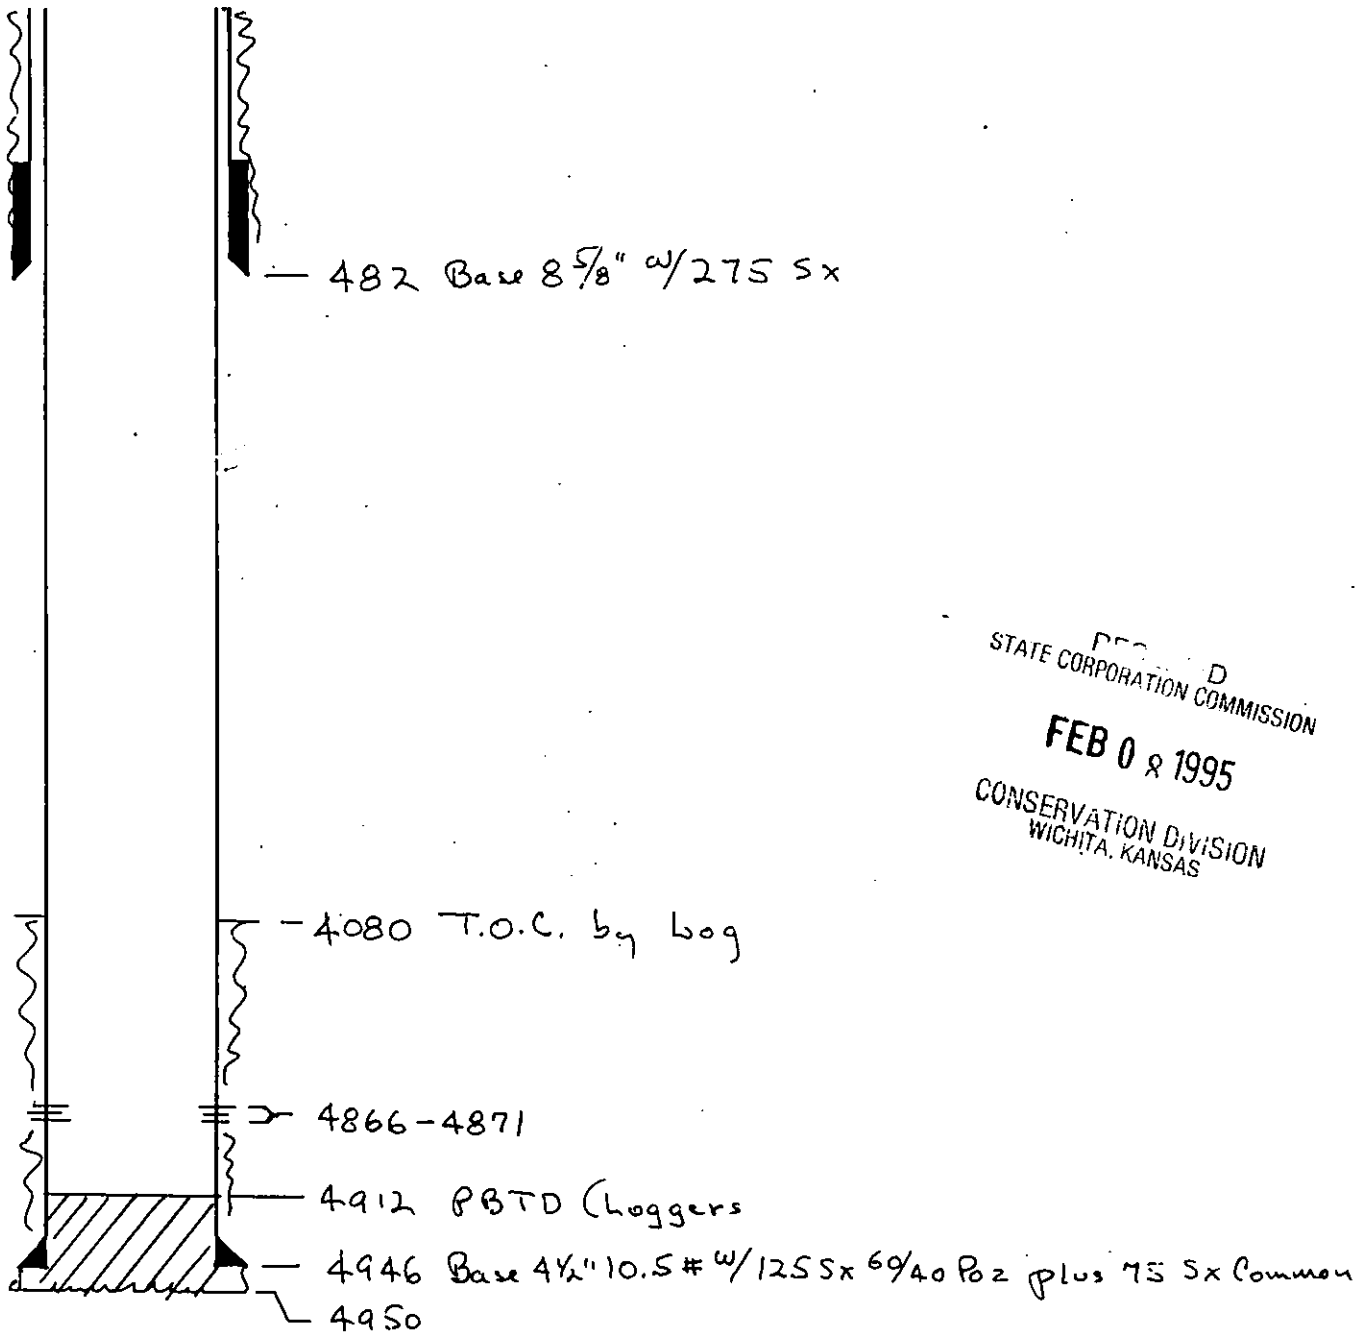

RECORDED
STATE CORPORATION COMMISSION
FEB 0 8 1995
CONSERVATION DIVISION
WICHITA, KANSAS

REMARKS: _____

