


Give All Information Completely
Make Required Affidavit
Mail or Deliver Report to:
Conservation Division
State Corporation Commission
P. O. Box 17027
Wichita, Kansas 67217
NORTH

WELL PLUGGING RECORD

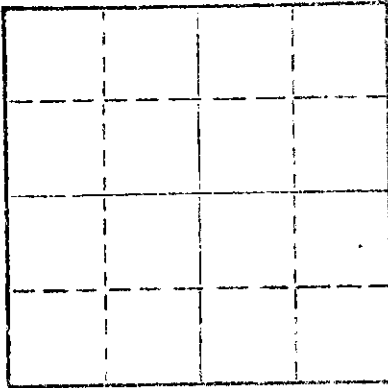

Locate well correctly on above Section Plat

Butler County, Sec. 30 Twp. 26 Rge. 8 (E E) (W)
Location as "NE/CNW/SW" or footage from lines SE SW SE
Lease Owner Lee Phillips Oil Company
Lease Name Drumm Institute Well No. 12
Office Address 1532 Vickers KSB&T Bldg, Wichita, Ks 67202
Character of Well (completed as Oil, Gas or Dry Hole) oil
Date well completed July 24 1970
Application for plugging filed March 28 1974
Application for plugging approved March 29 1974
Plugging commenced April 9 1974
Plugging completed April 11 1974
Reason for abandonment of well or producing formation depleted

If a producing well is abandoned, date of last production 19
Was permission obtained from the Conservation Division or its agents before plugging was commenced? yes

Name of Conservation Agent who supervised plugging of this well Mr. Ted E. Dewey
Producing formation Depth to top Bottom Total Depth of Well 2817 Feet

Show depth and thickness of all water, oil and gas formations.

OIL, GAS OR WATER RECORDS

CASING RECORD

FORMATION	CONTENT	FROM	TO	SIZE	PUT IN	PULLED OUT
				8 5/8"	201	none
				5 1/2"	2816	1866.79'

Describe in detail the manner in which the well was plugged, indicating where the mud fluid was placed and the method or methods used in introducing it into the hole. If cement or other plugs were used, state the character of same and depth placed, from feet to feet for each plug set.

Rig up and dig out cellar/ Put a 10' rock bridge at 2650' and added 5 sacks of cement to plug bottom. Put a 20' rock bridge at 225' to 205' and added 3 1/2 yards of ready mix cement to plug to surface.

RECEIVED
STATE CORPORATION COMMISSION
APR 17 1974
CONSERVATION DIVISION
Wichita, Kansas

(If additional description is necessary, use BACK of this sheet)
Name of Plugging Contractor The Buckeye Corporation
Address Box 1020, El Dorado, Ks 67042


STATE OF KANSAS, COUNTY OF BUTLER, ss.
Charles V. Cross (employee of owner) or (owner or operator) of the above-described well, being first duly sworn on oath, says: That I have knowledge of the facts, statements, and matters herein contained and the log of the above-described well as filed and that the same are true and correct. So help me God.

(Signature) [Signature]
Box 1020, El Dorado, Ks 67042
(Address)

SUBSCRIBED AND SWORN to before me this 15th day of April, 1974

[Signature]
Notary Public.

My commission expires

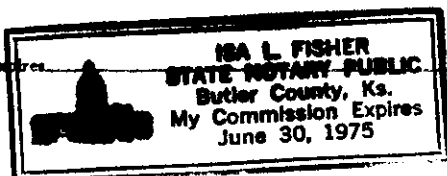

COMPANY: LEE PHILLIPS OIL CO.
CONTRACTOR: CROWE DRILLING CO., INC.

FARM: DRUMM INSTITUTE NO. 12
LOCATION: SE/4 SW/4 SE/4
Sec. 30-26-8E
Butler County, Kansas

COMMENCED: July 20, 1970
COMPLETED: July 24, 1970 (Rotary)

CASING RECORD:
201' 8 5/8" set w/150 sacks
5 1/2" set at 2816' w/80 sacks

<u>FORMATIONS</u>	<u>DEPTH</u>
Lime and shale	495'
Shale	960'
Lime and shale	1744'
Lensing lime	1924'
Shale	2065'
Kansas City Lime	2212'
Shale	2698'
Bartlesville Sand	2768'
Shale	2790'
Mississippi Lime	2817'
TOTAL DEPTH	2817'

RECEIVED
STATE CORPORATION COMMISSION
MAY 29 1974
CONSERVATION DIVISION
WICHITA, KANSAS

I hereby certify this to be a true and accurate log of the above described well as shown by the Daily Drilling Reports.

CROWE DRILLING COMPANY, INC.

J. J. Crowe

Subscribed and sworn to before me this 27th day of July, 1970.

Emyia Dominick
Notary Public

My commission expires June 21, 1974