

15-191-00803-0000


Form CP-4

STATE OF KANSAS  
STATE CORPORATION COMMISSION

Give All Information Completely  
Make Required Affidavit  
Mail or Deliver Report to:  
Conservation Division  
State Corporation Commission  
211 No. Broadway  
Wichita, Kansas

WELL PLUGGING RECORD

NORTH

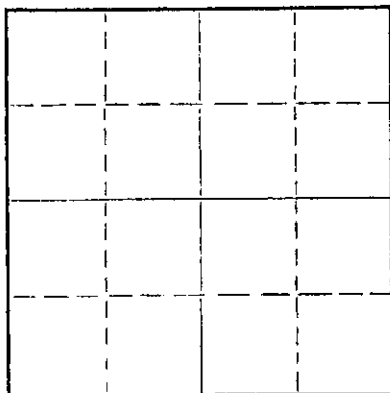

Locate well correctly on above  
Section Plat

County. Sec. 12 Twp. 31S Rge. 1W (E) (W)  
Location as "NE/CNW&SW&" or footage from lines NW NW NESE AUB ICC  
Lease Owner Kenneth Rupp  
Lease Name Dick Well No. 1  
Office Address 427 Union Center Wichita, Kansas  
Character of Well (completed as Oil, Gas or Dry Hole) dry hole  
Date well completed 12-31-1963  
Application for plugging filed " 19 "  
Application for plugging approved " 19 "  
Plugging commenced " 19 "  
Plugging completed " 19 "  
Reason for abandonment of well or producing formation dry hole

If a producing well is abandoned, date of last production 19  
Was permission obtained from the Conservation Division or its agents before plugging was commenced? yes

Name of Conservation Agent who supervised plugging of this well Paul Turpin  
Producing formation \_\_\_\_\_ Depth to top \_\_\_\_\_ Bottom \_\_\_\_\_ Total Depth of Well 4075 Feet  
Show depth and thickness of all water, oil and gas formations.

OIL, GAS OR WATER RECORDS

CASING RECORD

| FORMATION | CONTENT | FROM | TO | SIZE  | PUT IN | PULLED OUT |
|-----------|---------|------|----|-------|--------|------------|
|           |         |      |    | 8 5/8 | 386'   |            |
|           |         |      |    |       |        |            |
|           |         |      |    |       |        |            |
Describe in detail the manner in which the well was plugged, indicating where the mud fluid was placed and the method or methods used in introducing it into the hole. If cement or other plugs were used, state the character of same and depth placed, from \_\_\_\_\_ feet to \_\_\_\_\_ feet for each plug set.

Hole filled with heavy rotary mud  
to 230 ft. Bridge at 230' with hulls  
& wood & 15 sacks cement on bridge. Hole  
filled with heavy rotary mud. to 25 ft. **RECEIVED**  
Bridge at 25 ft. with hulls & 8 sacks **STATE CORPORATION COMMISSION**  
cement on bridge. Rat hole capped with  
2 sacks cement. JAN 10 1964

CONSERVATION DIVISION  
Wichita, Kansas

(If additional description is necessary, use BACK of this sheet)

Name of Plugging Contractor White & Ellis Drilling, Inc.  
Address Box 448 El Dorado, Kansas

STATE OF Kansas, COUNTY OF Butler, ss.  
Ernest Sifford (employee of contractor) (employee of contractor) of the above-described  
well, being first duly sworn on oath, says: That I have knowledge of the facts, statements, and matters herein contained and the log of the  
above-described well as filed and that the same are true and correct. So help me God.

(Signature) Ernest Sifford

(Address)

SUBSCRIBED AND SWORN TO before me this 9th day of January, 1964

My commission expires September 26, 1964

Notary Public.

## Casing Record

8 5/8

386' Cemented  
w/250 sacks

T. D.

4075'

Kelly Bushing Measurement 5' above ground level.

| FORMATION          | DEPTH |
|--------------------|-------|
| Shale & Sand       | 0-70  |
| Shale & Lime stks. | 260   |
| Lime & Shale       | 386   |
| Anhydrite & Shale  | 430   |
| Anhydrite          | 740   |
| Lime               | 750   |
| Shale & Shells     | 972   |
| Lime & Shale       | 1005  |
| Lime & Shale stks. | 1080  |
| Shale & Lime stks. | 1010  |
| Shale & Shells     | 1935  |
| Lime               | 2320  |
| Shale & Shells     | 2385  |
| Lime               | 2445  |
| Shale              | 2671  |
| Sand               | 2764  |
| Shale & Sand       | 2843  |
| Shale              | 2984  |
| Lime               | 3240  |
| Shale & Lime       | 3325  |
| Lime & Shale       | 3384  |
| Lime               | 3400  |
| Shale & Lime       | 3628  |
| Lime               | 3973  |
| Shale              | 4052  |
| Sand               | 4075  |

## TOPS

|             |      |
|-------------|------|
| Kansas City | 2984 |
| Mississippi | 3628 |
| Simpson     | 4052 |

15-11-00803-0000  
 Location: NW NW NE ~~SE~~ AUBKCC  
 Section: 12-31S-1W  
 Sumner County, Kansas  
 Farm: Dick #1  
 Well Owner: Kenneth Rupp  
 Contractor: White & Ellis Drig., Inc.  
 Commenced: 12/16/63  
 Completed: 12/31/63

**RECEIVED**  
 STATE CORPORATION COMMISSION  
 JAN 10 1964  
 CONSERVATION DIVISION  
 Wichita, Kansas

Dry Hole

Plugged &amp; Abandoned