


STATE OF KANSAS
STATE CORPORATION COMMISSION
CONSERVATION DIVISION
P. O. BOX 17027
WICHITA, KANSAS 67217

FORM CP-4

WELL PLUGGING RECORD

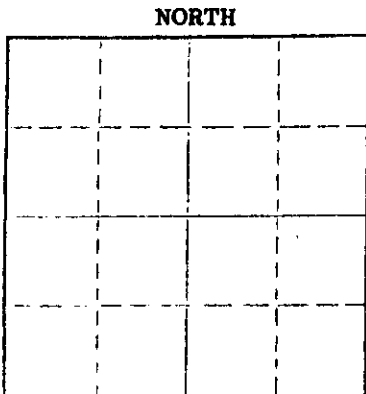

Locate well correctly on above
Section Plat

Butler County, Sec. 31 Twp. 26 Rge. 8 (E) E (W)
Location as "NE/CNW&SW" or footage from lines NE SW NE
Lease Owner Midwest Supply Company
Lease Name Drumm Institute Well No. 9
Office Address Box 830, El Dorado, Ks 67042
Character of Well (completed as Oil, Gas or Dry Hole) oil
Date well completed May 8 1970
Application for plugging filed January 23 1976
Application for plugging approved January 26 1976
Plugging commenced March 19 1976
Plugging completed March 23 1976
Reason for abandonment of well or producing formation depleted

If a producing well is abandoned, date of last production 19
Was permission obtained from the Conservation Division or its agents before plugging was commenced? yes

Name of Conservation Agent who supervised plugging of this well Mr. Ted E. Dewey
Producing formation _____ Depth to top _____ Bottom _____ Total Depth of Well 2810 feet
Show depth and thickness of all water, oil and gas formations.

OIL, GAS OR WATER RECORDS

CASING RECORD

FORMATION	CONTENT	FROM	TO	SIZE	PUT IN	PULLED OUT
				8 5/8"	160	none
				5 1/2"	2810	1588.91

Describe in detail the manner in which the well was plugged, indicating where the mud fluid was placed and the method or methods used in introducing it into the hole. If cement or other plugs were used, state the character of same and depth placed, from _____ feet to _____ feet for each plug set.

Move in, rig up and dig out cellar. Set 10' rock bridge at 2650' and added 5 sacks of cement to plug bottom. Set 20' rock bridge at 220' to 200' and added 3 1/2 yards of ready-mix cement to plug to surface.

(If additional description is necessary, use BACK of this sheet)

Name of Plugging Contractor THE BUCKEYE CORPORATION
Address BOX 1020, EL DORADO, KS 67042

STATE OF KANSAS COUNTY OF BUTLER
Charles V. Cross ss.

(employee of owner) or (owner or operator) of the above-described well, being first duly sworn on oath, says: That I have knowledge of the facts, statements, and matters herein contained and the log of the above-described well as filed and that the same are true and correct. So help me God.

(Signature) *Charles V. Cross*
Box 1020, El Dorado, Ks 67042
(Address)

SUBSCRIBED AND SWORN TO before me this 29th day of March 1976.

My commission expires



Notary Public.

3-30-76

7/11/1970

COMPANY: LEE PHILLIPS OIL CO.
CONTRACTOR: CROWE DRILLING CO., INC.

FARM: DRUMM INSTITUTE NO. 9
LOCATION: NE SW NE Sec. 31-26-8E
Butler County, Kansas

COMMENCED: May 3, 1970
COMPLETED: May 8, 1970 (Rotary)

CASING RECORD:
160' of 8 5/8" set w/85 sacks
5 1/2" set at 2810' w/80 sacks

<u>FORMATIONS</u>	<u>DEPTH</u>	
Lime	420'	
Lime and shale	1070'	
Lime	1110'	
Lime and shale	1240'	Perf. 2690-98 w/32 shots.
Shale and shells	1726'	
Lansing lime	1906'	
Shale	2069'	Perf. 2788-90 & 2792-98.
Kansas City Lime	2218'	
Shale	2490'	
Shale and shells	2687'	
Sand	2760'	
Shale	2780'	
Mississippi	2810'	
Total depth	2810'	

I hereby certify this to be a true and accurate log of the above described well as shown by the Daily Drilling Reports.

CROWE DRILLING COMPANY, INC.

J. Helrowe

Subscribed and sworn to before me this 11th day of May, 1970.

Emma Dominick
Notary Public

My commission expires June 21, 1970