


Give All Information Completely  
Make Required Affidavit  
Mail or Deliver Report to:  
Conservation Division  
State Corporation Commission  
212 No. Market  
Wichita, Kansas

WELL PLUGGING RECORD

15101-2 0314-0000

NORTH

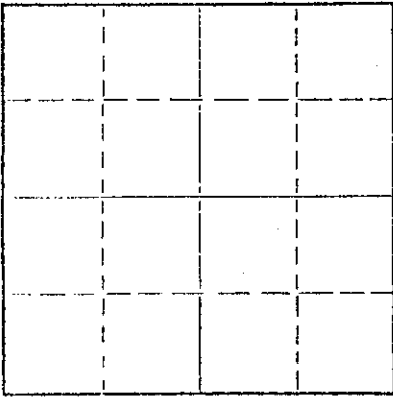

Locate well correctly on above  
Section Plat

Lane \_\_\_\_\_ County. Sec. 35 Twp. 17 Rge. 28W (E) \_\_\_\_\_ (W) \_\_\_\_\_  
Location as "NE/CNW&SW" or footage from lines. SW SE NW  
Lease Owner Donald C. Slawson  
Lease Name Wheatcroft 'I' Well No. 1  
Office Address 200 Douglas Building  
Character of Well (completed as Oil, Gas or Dry Hole) Dry hole  
Date well completed May 23, 1978  
Application for plugging filed May 23, 1978  
Application for plugging approved May 23, 1978  
Plugging commenced May 23, 1978  
Plugging completed May 23, 1978  
Reason for abandonment of well or producing formation dry hole

If a producing well is abandoned, date of last production \_\_\_\_\_ 19\_\_\_\_  
Was permission obtained from the Conservation Division or its agents before plugging was commenced? yes

Name of Conservation Agent who supervised plugging of this well Gilbert Balthazor  
Producing formation \_\_\_\_\_ Depth to top \_\_\_\_\_ Bottom \_\_\_\_\_ Total Depth of Well 4610 Feet  
Show depth and thickness of all water, oil and gas formations.

OIL, GAS OR WATER RECORDS

CASING RECORD

FORMATION	CONTENT	FROM	TO	SIZE	PUT IN	PULLED OUT
	284.15	surface	291'	8 5/8"		

Describe in detail the manner in which the well was plugged, indicating where the mud fluid was placed and the method or methods used in introducing it into the hole. If cement or other plugs were used, state the character of same and depth placed, from \_\_\_\_\_ feet to \_\_\_\_\_ feet for each plug set.

1st plug @ 750' w/70 sx  
2nd plug @ 240' w/20 sx  
Bridge @ 40' w/10 sx  
2 sx in rat hole

6-23-78

(If additional description is necessary, use BACK of this sheet)

Name of Plugging Contractor Donald C. Slawson  
Address 200 Douglas Building Wichita, Kansas 67202

STATE OF KANSAS, COUNTY OF SEDGWICK, ss.  
R. J. THATCHER (employee of owner) or (owner or operator) of the above-described well, being first duly sworn on oath, says: That I have knowledge of the facts, statements, and matters herein contained and the log of the above-described well as filed and that the same are true and correct. So help me God.

(Signature) R. J. Thatcher  
R.J. Thatcher 200 Douglas Building

(Address)

Subscribed 22nd day of June 1978



Sherry L. Milford  
Sherry L. Milford Notary Public.