

STATE OF KANSAS
CORPORATION COMMISSION


Give All Information Completely
Make Required Affidavit
Mail or Deliver Report to:
Conservation Division
State Corporation Commission
211 No. Broadway
Wichita, Kansas

WELL PLUGGING RECORD

Comanche County, Sec. 28 Twp. 34S Rge. 17W (E) (W)

Location as "NE/CNW*SW*" or footage from lines C SW SE
Lease Owner Surray Mid-Continent Oil Company
Lease Name Charles Jackson Unit Well No. 1
Office Address 321 West Douglas - Wichita, Kansas
Character of Well (completed as Oil, Gas or Dry Hole) Dry Hole
Date well completed August 17 19 61
Application for plugging filed August 17 19 61
Application for plugging approved August 21 19 61
Plugging commenced August 17 19 61
Plugging completed August 17 - 10 A.M. 19 61
Reason for abandonment of well or producing formation Dry Hole

NORTH

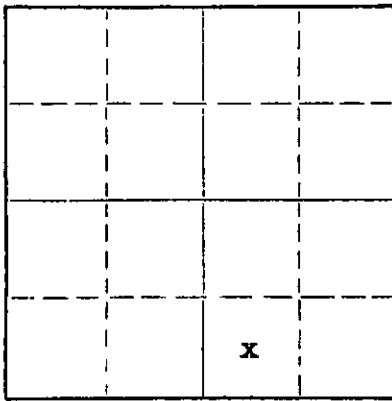

Locate well correctly on above
Section Plat

If a producing well is abandoned, date of last production None 19
Was permission obtained from the Conservation Division or its agents before plugging was com-
menced? Yes

Name of Conservation Agent who supervised plugging of this well Fred Hampel
Producing formation None Depth to top Bottom Total Depth of Well 6195 Feet
Show depth and thickness of all water, oil and gas formations.

OIL, GAS OR WATER RECORDS

CASING RECORD

FORMATION	CONTENT	FROM	TO	SIZE	PUT IN	PULLED OUT
Heedner	Dry	4360	4374	10-3/4"	815	0
Cherokee	Dry	5234	5314			
Simpson	Water	6188	TD			

Describe in detail the manner in which the well was plugged, indicating where the mud fluid was placed and the method or methods used in introducing it into the hole. If cement or other plugs were used, state the character of same and depth placed, from feet to feet for each plug set.

Filled hole with mud to 500'. Set plug and filled hole with 35 sacks cement from 500' to 425'. Filled hole with mud to 15' and set 15 sack cement plug to surface.

RECEIVED
STATE CORPORATION COMMISSION
AUG 23 1961
CONSERVATION DIVISION
Wichita, Kansas

(If additional description is necessary, use BACK of this sheet)
Name of Plugging Contractor Mora Drilling Company
Address 800 Midstates Building - Tulsa, Oklahoma

STATE OF Kansas, COUNTY OF Sedgwick, ss.
Nash A. Gough (employee of owner) of the above-described well, being first duly sworn on oath, says: That I have knowledge of the facts, statements, and matters herein contained and the log of the above-described well as filed and that the same are true and correct. So help me God.

(Signature) Nash A. Gough
321 West Douglas - Wichita, Kansas
(Address)

SUBSCRIBED AND SWORN TO before me this 25th day of August, 19 61

My commission expires July 13, 1963

Wm. J. [Signature] Notary Public.



MORA DRILLING COMPANY

1900 FIRST NATIONAL BUILDING

TULSA 3, OKLAHOMA

August 18, 1961

Sunray Mid-Continent Oil Co.
Tulsa, Okla.

The followig is drillers log of C. Jackson #1 located in the
C SW SW Sec. 28-34S-17W Comanche County, Kansas.

Drilling started July 15, 1961
Drilling completed Aug. 16, 1961

Formation	From	To
Red bed , shale and lime	0	815
Shale and sand	815	1000
Shale	1000	1839
Shale and sand	1839	2250
Lime and sand	2250	2475
Lime	2475	3268
Lime and shale	3268	4335 4335
Lime	4335	5896
Lime and shale	5896	6008
Lime	6008	6195 TD

Mora Drilling Co.

J. R. Burris

RECEIVED
STATE CORPORATION COMMISSION

AUG 29 1961

CONSERVATION DIVISION
Wichita, Kansas