


WELL PLUGGING RECORD

Give All Information Completely
Make Required Affidavit
Mail or Deliver Report to:
Conservation Division
State Corporation Commission
211 No. Broadway
Wichita, Kansas

Stafford County, Sec. 34 Twp. 22S Rge. 11 (E) W (W)
Location as "NE/CNW*SW*" or footage from lines SW SW NW
Lease Owner Anschutz Drilling Co., Inc.
Lease Name Gates Well No. 1
Office Address 709 Union Natl. Bldg., Wichita, Kansas
Character of Well (completed as Oil, Gas or Dry Hole) Dry Hole
Date well completed July 2 19 56
Application for plugging filed July 3 19 56
Application for plugging approved July 3 19 56
Plugging commenced July 3 19 56
Plugging completed July 3 19 56
Reason for abandonment of well or producing formation Dry

NORTH

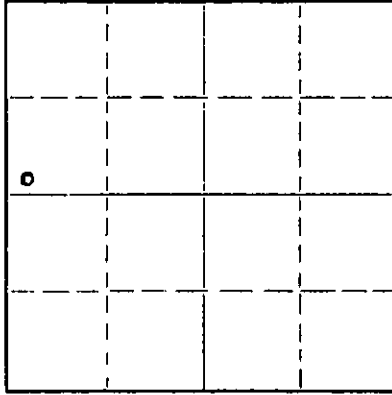

Locate well correctly on above
Section Plat

If a producing well is abandoned, date of last production _____ 19 ____
Was permission obtained from the Conservation Division or its agents before plugging was com-
menced? Yes

Name of Conservation Agent who supervised plugging of this well R. M. Brundege
Producing formation _____ Depth to top _____ Bottom _____ Total Depth of Well 3675 Feet
Show depth and thickness of all water, oil and gas formations.

OIL, GAS OR WATER RECORDS

CASING RECORD

FORMATION	CONTENT	FROM	TD	SIZE	PUT IN	PULLED OUT
				8-5/8"	253'	

Describe in detail the manner in which the well was plugged, indicating where the mud fluid was placed and the method or methods used in introducing it into the hole. If cement or other plugs were used, state the character of same and depth placed, from _____ feet to _____ feet for each plug set.

Bottom plug @ 240' with 20 sacks cement.
Top plug @ 35' with 8 sacks cement.

7-10-56

(If additional description is necessary, use BACK of this sheet)

Name of Plugging Contractor Anschutz Drilling Co., Inc.
Address 709 Union Natl. Bldg., Wichita, Kansas

STATE OF Kansas, COUNTY OF Sedgwick, ss.
Shirley Salley (employee of owner) or (owner or operator) of the above-described well, being first duly sworn on oath, says: That I have knowledge of the facts, statements, and matters herein contained and the log of the above-described well as filed and that the same are true and correct. So help me God.

(Signature) Shirley Salley
709 Union Natl. Bldg., Wichita, Kansas
(Address)

SUBSCRIBED AND SWORN TO before me this 7th day of July, 19 56

My commission expires April 27, 1959
Lawrence R. Stevenson
Notary Public.

PLUGGING
FILE SEC 34 T 22 R 11W
BOOK PAGE 77 LINE 11

15-185-00928-0000

DRILLERS' LOG

Anschutz Drilling Co., Inc.
#1 Gates
SW SW NW Sec. 34-22S-11W
Stafford County, Kansas

<u>FROM</u>	<u>TO</u>	
0	130	Sand
130	512	Red bed
512	545	Anhydrite
545	890	Gumbo shale
890	1198	Shale
1198	1490	Shale and shells
1490	1620	Lime - Ft. Riley
1620	1730	Lime and shale
1730	1890	Lime
1890	2850	Lime and shale
2850	2945	Lime
2945	3055	Lime and shale
3055	3190	Shale
3190	3315	Shale and lime
3315	3443	Lime
3443	3503	Lime and shale
3503	3540	Lime
3540	3620	Lime and shale
3620	3675	Lime
	3675	Total Depth

CASING RECORD:

8-5/8" surface casing
@ 253' with 175 sacks
cement, 200# calcium
chloride, 2% gel.

COMMENCED: 6/22/56

COMPLETED: 7/3/56

D & A

STATE OF KANSAS)
) SS
COUNTY OF SEDGWICK)

I hereby affirm that the above and foregoing is a true and correct copy of the formations encountered on the #1 Gates, SW SW NW of Section 34-22S-11W, Stafford County, Kansas, as reflected by the daily drilling reports.

ANSCHUTZ DRILLING CO., INC.

By: *Shirley Salley*
Shirley Salley

Subscribed and sworn to before me this 7th day of July, 1956.

My Commission Expires: April 27, 1959

Frank A. Peterson
Notary Public

PLUGGING
FILE SEC. 34 T. 22 R. 11W
BOOK PAGE 77 LINE 11