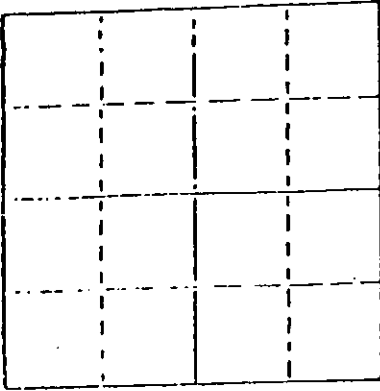


15-035-21886-0000

STATE OF KANSAS
STATE CORPORATION COMMISSION

WELL PLUGGING RECORD

Give All Information Completely
Make Required Affidavit
Mail or Deliver Report to
Conservation Division
State Corporation Comm.
245 North Water
Wichita, KS 67202

Locate well correctly on above
Section Plat

Cowley County, Sec. 1 Twp. 33S Rge. 5 E/W
Location as "NE/CNW $\frac{1}{4}$ SW $\frac{1}{4}$ " or footage from lines

NE SE NE
Lease Owner Range Oil Company, Inc.
Lease Name Chrisler Well No. 2
Office Address 240 Page Court, 220 W. Douglas, Wichita, Ks.
Character of Well (Completed as Oil, Gas or Dry Hole)

Dry Hole
Date Well completed 4-26 1978
Application for plugging filed 4-26 1978
Application for plugging approved 4-26 1978
Plugging commenced 4-26 1978
Plugging completed 4-26 1978
Reason for abandonment of well or producing formation

Dry
If a producing well is abandoned, date of last production 19

Was permission obtained from the Conservation Division or
its agents before plugging was commenced? Yes

Name of Conservation Agent who supervised plugging of this well Mr. Massey
Producing formation Dry Depth to top Bottom Total Depth of Well
Show depth and thickness of all water, oil and gas formations.

OIL, GAS OR WATER RECORDS

CASING RECORD

FORMATION	CONTENT	FROM	TO	SIZE	PUT IN	PULLED OUT
				8-5/8	190	0

Describe in detail the manner in which the well was plugged, indicating where the mud fluid was placed and the method or methods used in introducing it into the hole. If cement or other plugs were used, state the character of same and depth placed, from feet to feet for each plug set.

Mud from 3165' to 210'

8-5/8 wooden plug, 1/2 sx hulls and 25 sx cement from 210' to 135'

Mud from 135 to 40'

8-5/8 wooden plug, 1/2 sx hulls, cement 40' to surface

RECEIVED
STATE CORPORATION COMMISSION

MAY 08 1978

5-8-78

Wichita, Kansas

(If additional description is necessary, use BACK of this sheet)

Name of Plugging Contractor Range Drilling Co., Inc.

STATE OF Kansas COUNTY OF Sedgwick, ss.
Gary L. Reed (employee of owner) or (owner or operator)
of the above-described well, being first duly sworn on oath, says: That I have knowledge of the facts, statements, and matters herein contained and the log of the above-described well as filed and that the same are true and correct. So help me God.

(Signature)


Gary L. Reed

(Address)

3 day of May, 19 78

Norm S. Davidson

Notary Public.

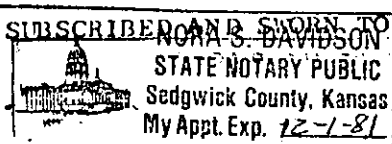

My commission expires

KANSAS DRILLERS LOG

API No. 15 — 035 — 21886 — 0000
County Number

Operator

Range Oil Company, Inc.

Address

240 Page Court 220 W. Douglas, Wichita, Kansas 67202

Well No.

2

Lease Name

Chrisler

Footage Location

990

feet from (S) line

330

feet from (E) line

Principal Contractor

Range Drilling Co., Inc.

Geologist

Earl Moore

Spud Date

4-15-78

Total Depth

3165

P.B.T.D.

Date Completed

4-27-78


Oil Purchaser

S. 1 T. 33S R. 5 E

Loc. NE SE NE

County Cowley

640 Acres
N

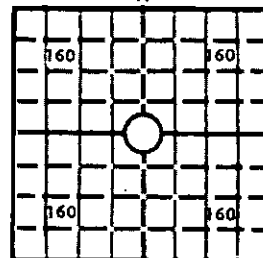

Locate well correctly

1302

Elev.: Gr.

DF 1306

KB

1309

CASING RECORD

Report of all strings set—surface, intermediate, production, etc.

Purpose of string	Size hole drilled	Size casing set (in O.D.)	Weight lbs/ft.	Setting depth	Type cement	Sacks	Type and percent additives
Surface	12-3/4	8-5/8	28#	184	Common	85	3 CC + 1 gel.

LINER RECORD

PERFORATION RECORD

Top, ft.	Bottom, ft.	Sacks cement	Shots per ft.	Size & type	Depth interval

TUBING RECORD

Size	Setting depth	Packer set at			

ACID, FRACTURE, SHOT, CEMENT SQUEEZE RECORD


Amount and kind of material used	Depth interval treated

RECEIVED
STATE CORPORATION COMMISSION
MAY 08 1978
CONSERVATION DIVISION
Wichita, Kansas

INITIAL PRODUCTION

Date of first production		Producing method (flowing, pumping, gas lift, etc.)			
RATE OF PRODUCTION PER 24 HOURS		Oil bbls.	Gas MCF	Water bbls.	Gas-oil ratio CFPB
Disposition of gas (vented, used on lease or sold)				Producing interval(s)	

INSTRUCTIONS: As provided in KCC Rule 82-2-125, within 90 days after completion of a well, one completed copy of this Drillers Log shall be transmitted to the State Geological Survey of Kansas, 4150 Monroe Street, Wichita, Kansas 67209. Copies of this form are available from the Conservation Division, State Corporation Commission, 3830 So. Meridian (P.O. Box 17027), Wichita, Kansas 66217. Phone AC 316-522-2206. If confidential custody is desired, please note Rule 82-2-125. Drillers Logs will be on an open file in the Oil and Gas Division, State Geological Survey of Kansas, Lawrence, Kansas 66044.

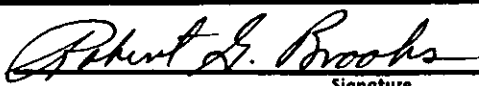Operator Range Oil Co., Inc.		15-035-21886-0000		DESIGNATE TYPE OF COMP.: OIL, GAS, DRY HOLE, SWDW, ETC.: D & A	
Well No. 2	Lease Name Chrisler				
S 1 T 33R 5 E XX					
WELL LOG				SHOW GEOLOGICAL MARKERS, LOGS RUN, OR OTHER DESCRIPTIVE INFORMATION.	
Show all important zones of porosity and contents thereof; cored intervals, and all drill-stem tests, including depth interval tested, cushion used, time tool open, flowing and shut-in pressures, and recoveries.					
FORMATION DESCRIPTION, CONTENTS, ETC.	TOP	BOTTOM	NAME	DEPTH	
Sand - Water	1862	1967	Stalnaker		
Sand - Water	2286	2391	Layton		
Lime	2420	2590	KC		
Lime	2666	2792	Oswego		
Shale	2791	3038	Cherokee		
Miss. Chert.	3038	3051	Mississippian		
Miss. Dolo.	3051	3061	"		
Miss. Lime	3061	3165	"		
USE ADDITIONAL SHEETS, IF NECESSARY, TO COMPLETE WELL RECORD.					
Date Received	 Signature Exploration Manager Title May 3, 1978 Date				