


WELL PLUGGING RECORD

Give All Information Completely  
Make Required Affidavit  
Mail or Deliver Report to:  
Conservation Division  
State Corporation Commission  
800 Bitting Building  
Wichita, Kansas

Summer County. Sec. 11, Twp. 33 Rge. 2 (NE)X (W)  
Location as "NE/CNWKSWK" or footage from lines  
Lease Owner The Carter Oil Company  
Lease Name H. D. Smiley Well No. 1  
Office Address \_\_\_\_\_  
Character of Well (completed as Oil, Gas or Dry Hole) Oil  
Date well completed 11/16 19 47.  
Application for plugging filed \_\_\_\_\_ 19 \_\_\_\_  
Application for plugging approved \_\_\_\_\_ 19 \_\_\_\_  
Plugging commenced Sept. 3 19 57  
Plugging completed Sept. 16 19 57  
Reason for abandonment of well or producing formation \_\_\_\_\_

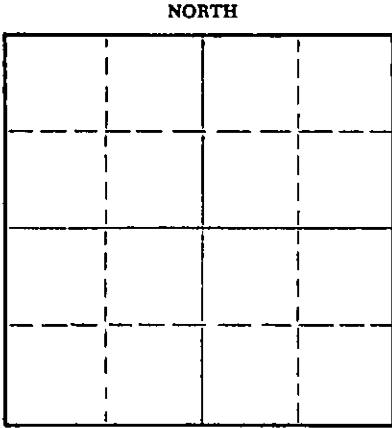

Locate well correctly on above Section Plat

If a producing well is abandoned, date of last production \_\_\_\_\_ 19 \_\_\_\_  
Was permission obtained from the Conservation Division or its agents before plugging was commenced? Yes

Name of Conservation Agent who supervised plugging of this well Eugene Graham  
Producing formation \_\_\_\_\_ Depth to top \_\_\_\_\_ Bottom \_\_\_\_\_ Total Depth of Well \_\_\_\_\_ Feet  
Show depth and thickness of all water, oil and gas formations.

OIL, GAS OR WATER RECORDS


CASING RECORD

FORMATION	CONTENT	FROM	TO	SIZE	PUT IN	PULLED OUT
Kansas City		3209		10"	532'	0
Mississippi		3900		6 5/8"	4233'	2813'
Kinderhook		4170				
Simpson		4238				

Describe in detail the manner in which the well was plugged, indicating where the mud fluid was placed and the method or methods used in introducing it into the hole. If cement or other plugs were used, state the character of same and depth placed, from \_\_\_\_\_ feet to \_\_\_\_\_ feet for each plug set.

Filled back to 4230' for well site sale

Filled back to 4230'. Dumped 6 sacks of cement. Shot pipe off at 2813'. Pulled pipe and mudded hole to 240'. Set rock bridge and dumped 15 sacks of cement. Mudded to 40', and set rock ridge. Dumped 10 sacks of cement at top of surface.

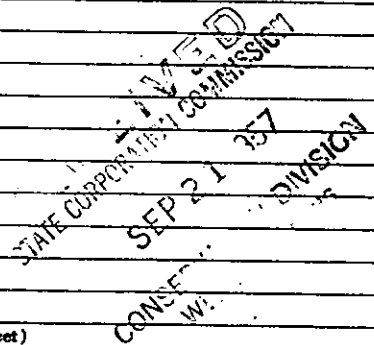

(If additional description is necessary, use BACK of this sheet)  
Name of Plugging Contractor Bert Self Casing Pulling Co.,  
Address R.R. #4 Hutchinson, Kansas.

STATE OF Kans. COUNTY OF Reno, ss.  
Employee (employee of owner) or (owner or operator) of the above-described well, being first duly sworn on oath, says: That I have knowledge of the facts, statements, and matters herein contained and the log of the above-described well as filed and that the same are true and correct. So help me God.

(Signature) Bert Self  
R. R. #4, Hutchinson, Kans.  
(Address)

SUBSCRIBED AND SWORN TO before me this 17th day of Sept. 19 57

My commission expires August 12, 1961

Barth Self  
Notary Public.

PLUGGING  
FILE SEC. 11. T. 33 R. 2W  
BOOK PAGE 36 LINE 2

15-191-10324-8890

WELL LOG BUREAU - KANSAS GEOLOGICAL SOCIETY  
412 Union National Bk. Bldg. Wichita, Kansas

Company - THE CARTER OIL COMPANY  
Farm - H.D. Smeley No. 1

SEC. 11 T. 33 R. 2W  
ONE SE

Total Depth. 4243'  
Comm. 11-16-47 Comp. 12-8-47  
Shot or Treated.  
Contractor.  
Resued. 8-14-48

County. Sumner

KANSAS



**CASING:**  
10-3/4" 532' Cem. w/300 sx  
6-5/8" 4238' Cem. w/175 sx

Elevation. \_\_\_\_\_

Production. 390 BO/24 hours

Figures Indicate Bottom of Formations.

surface & red bed	0-65
shale & shells	375
shale, shells, gyp & salt	440
lime & shale	530
lime	560
lime & shale	755
shale & lime shells	870
shale & shells	990
shale, lime & shells	1090
lime & shale	1395
shale	1625
shale & shells	2115
lime & shale	2180
lime	2580
lime & shale	2740
shale	2908
sand	2958
shale	3214
lime	3376
lime & shale	3458
shale	3715
shale & shells	3760
shale	3900
lime	4174
shale	4232
shale & sand	4238
sand	4243
Total Depth	

Tops:  
Kansas City 3209  
Mississippi 3900  
Kinderhook 4170  
Simpson 4238

RECORDED  
STATE COMMISSION

AUG 10 1957

CONSERVATION DIVISION  
Wichita, Kansas

**PLUGGING**  
FILE SEC. 11 T. 33 R. 2W  
BOOK PAGE 36 LINE 2