

CARD MUST BE TYPED

State of Kansas
NOTICE OF INTENTION TO DRILL
(see rules on reverse side)

CARD MUST BE SIGNED

Starting Date: January 10, 1984
month day year

OPERATOR: License # 9641

Name Stauffer Oil & Gas

Address P. O. Box 6

City/State/Zip Liberal, KS 67901

Contact Person R. F. Burke

Phone 316-624-3767

CONTRACTOR: License # unknown

Name unknown

City/State

Well Drilled For: Well Class: Type Equipment:

☒ Oil ☐ Swd ☐ Infield ☒ Mud Rotary☐ Gas ☐ Inj ☒ Pool Ext. ☐ Air Rotary☐ OWWO ☐ Expl ☐ Wildcat ☐ Cable

If OWWO: old well info as follows:

Operator

Well Name

Comp Date **Old Total Depth**

Projected Total Depth 4600 feet

Projected Formation at TD Mississippi

Expected Producing Formations Lansing/KC, Oswego,...

Cherokee, Mississippi

I certify that we will comply with K.S.A. 55-101, et seq., plus eventually plugging hole to K.C.C. specifications.

Date 12-26-84 Signature of Operator or Agent [Signature]

API Number 15- 101-21, 111-6000
20 K566

NW NW NW . . . Sec . 1 . . Twp . 19 S, Rge ~~29~~ ☒ West

.....4950..... Ft North from Southeast Corner of Section

4950 Ft West from Southeast Corner of Section

(Note: Locate well on Section Plat on reverse side)

Nearest lease or unit boundary line330..... feet.

County Lane

| | | | |
|--------|----------|-------|---|
| County | M. Dodge | Well# | 1 |
|--------|----------|-------|---|

Domestic well within 330 feet : ☐ yes ☒ no

Municipal well within one mile : ☐ yes ☒ no

Depth to Bottom of fresh water150..... feet

Lowest usable water formation Dakota.....

Depth to Bottom of usable water1200..... feet

Surface pipe by Alternate : 1 ☐ 2 ☒

Surface pipe to be set250..... feet

Conductor pipe if any required ..None..... feet

Ground surface elevation **feet MSL.**

This Authorization Expires 6-27-85

Approved By RS4/KC 12-27-84

Title Agent

Form C-1 4/84

THC/COKE 12/29/84

Must be filed with the K.C.C. five (5) days prior to commencing well
This card void if drilling not started within six (6) months of date received by K.C.C.

RECEIVED
STATE CORPORATION COMMISSION

12-27-84
DEC 27 1984

RECEIVED
STATE CORPORATION COMMISSION


~~DEC 30 1984~~

Important procedures to follow:

A Regular Section of Land
1 Mile = 5,280 Ft.

CONSERVATION DIVISION
Wichita, Kansas
Notify District office before setting surface casing.
Set surface casing by circulating cement to the top.

3. File completion forms ACO-1 with K.C.C. within 90 days of well completion, following instructions on ACO-1, side 1, and including copies of wireline logs.
4. Notify District office 48 hours prior to old well workover or re-entry.
5. Prior to plugging, prepare a plugging plan, then obtain agreement from the appropriate district office for an approved plugging plan.
6. Submit plugging report (CP-4) to K.C.C. after plugging is completed.
7. Obtain an approved injection docket number before disposing of salt water.
8. Notify K.C.C. within 10 days when injection commences or terminates.
9. If an alternate 2 completion, cement in the production pipe from below any usable water to surface within 120 days of spud date.

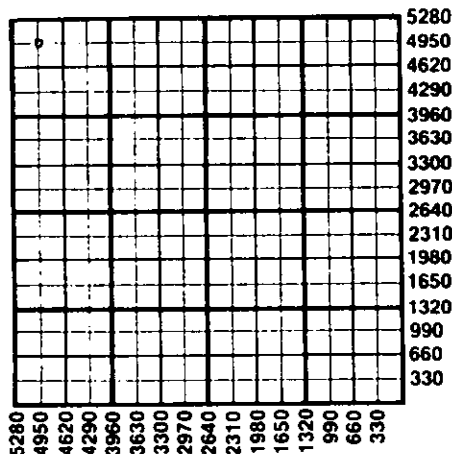

State Corporation Commission of Kansas
Conservation Division
200 Colorado Derby Building
Wichita, Kansas 67202
(316) 263-3238