

CARD MUST BE TYPED

State of Kansas

CARD MUST BE SIGNED

NOTICE OF INTENTION TO DRILL

(see rules on reverse side)

Starting Date 2/01/87
 month day year

API Number 15- 101-21,357-0000

OPERATOR: License # 4767
 Name Ritchie Exploration, Inc.
 Address 125 N. Market, Suite 1000
 City/State/Zip Wichita, KS 67202
 Contact Person Rocky Milford
 Phone 316/267-4375

SE SE SE. Sec. 26 Twp. 17 S, Rg. 28 East
330 Ft. from South Line of Section
330 Ft. from East Line of Section

(Note: Locate well on Section Plat on reverse side)

CONTRACTOR: License # 6033
 Name Murfin Drilling Co.
 City/State Wichita, KS

Nearest lease or unit boundary line 330 feet
 County Lane

Lease Name Ken Hartman Well # 1
 Ground surface elevation est. 2715' feet MSL

Well Drilled For: Well Class: Type Equipment:
X Oil SWD Infield X Mud Rotary
Gas Inj Pool Ext. Air Rotary
OWWO Expl X Wildcat Cable

Domestic well within 330 feet: yes X no
 Municipal well within one mile: yes X no

Depth to bottom of fresh water 150'

Depth to bottom of usable water 1350'

Surface pipe by Alternate: 1 2 X

Surface pipe planned to be set 240'

Conductor pipe required

Projected Total Depth 4650 feet

Formation Mississippian

If OWWO: old well info as follows:

Operator

Well Name

Comp Date Old Total Depth

I certify that well will comply with K.S.A. 55-101, et seq., plus eventually plugging hole to KCC specifications.

Date 1/07/87 Signature of Operator or Agent Rocky Milford Title Geologist

For KCC Use:

Conductor Pipe Required 200 feet; Minimum Surface Pipe Required 402 feet per Alt.

This Authorization Expires 7-9-87 Approved By 1-9-86


[Signature]

Must be filed with the K.C.C. five (5) days prior to commencing well
This card void if drilling not started within six (6) months of date received by K.C.C.

Important procedures to follow:

1. Notify District office before setting surface casing.
2. Set surface casing by circulating cement to the top.
3. File completion forms ACO-1 with K.C.C. within 90 days of well completion, following instructions on ACO-1, side 1, and including copies of wireline logs.
4. Notify District office 48 hours prior to old well workover or re-entry.
5. Prior to filing Intent, prepare a proposed plugging plan in case well is D & A, then obtain approval of plan when calling district office prior to setting surface pipe.
6. Submit plugging report (CP-4) to K.C.C. after plugging is completed.
7. Obtain an approved injection docket number before disposing of salt water.
8. Notify K.C.C. within 10 days when injection commences or terminates.
9. If an alternate 2 completion, cement in the production pipe from below any usable water to surface within 120 days of spud date.

**A Regular Section of Land
1 Mile = 5,280 Ft.**

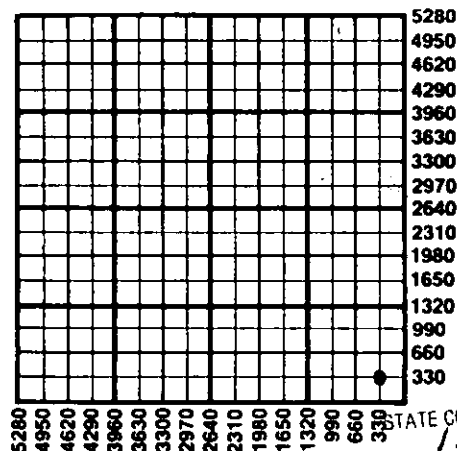

STATE CORPORATION COMMISSION
1-9-87
JAN 9 1987
CONSERVATION DIVISION
Wichita, Kansas

State Corporation Commission of Kansas
Conservation Division
200 Colorado Derby Building
Wichita, Kansas 67202
(316) 263-3238