

CARD MUST BE TYPED

State of Kansas  
**NOTICE OF INTENTION TO DRILL**  
(see rules on reverse side)

CARD MUST BE SIGNED

Starting Date: May 16, 1985  
month day year 3-45

API Number IS- 101-21,173-0000

OPERATOR: License # 5068  
Name Thomas E. Black  
Address 527 Union Center Bldg.  
City/State/Zip Wichita, Kansas 67202  
Contact Person Thomas E. Black  
Phone 316-264-9342

NE SW SW Sec 26 Twp 17 S, Rge 28  East  
(location)  West

990 Ft North from Southeast Corner of Section  
4290 Ft West from Southeast Corner of Section  
(Note: Locate well on Section Plat on reverse side)

CONTRACTOR: License # 5110  
Name B & B Drilling, Inc.  
City/State Wichita, Kansas 67202

Nearest lease or unit boundary line 990 feet.  
County Lane  
Lease Name HARTMAN Well# 1

Well Drilled For: Well Class: Type Equipment:  
 Oil  Swd  Infield  Mud Rotary  
 Gas  Inj  Pool Ext.  Air Rotary  
 OWWO  Expl  Wildcat  Cable

Domestic well within 330 feet:  yes  no  
Municipal well within one mile:  yes  no

If OWWO: old well info as follows:  
Operator .....  
Well Name .....  
Comp Date ..... Old Total Depth .....  
Projected Total Depth 4600 feet  
Projected Formation at TD Mississippi  
Expected Producing Formations Lansing-Ft. Scott, Miss.

Depth to Bottom of fresh water ..... feet  
Lowest usable water formation Dakota  
Depth to Bottom of usable water 1000 feet  
Surface pipe by Alternate: 1  2   
Surface pipe to be set 300 feet  
Conductor pipe if any required ..... feet  
Ground surface elevation ..... feet MSL  
This Authorization Expires 11-14-85  
Approved By 5-14-85


I certify that we will comply with K.S.A. 55-101, et seq., plus eventually plugging hole to K.C.C. specifications of Production casing will be cemented immediately  
Date 5/14/85 Signature of Operator or Agent Thomas E. Black Title Owner

Form C-1 4/84  
2m HC/10014E 5-14-85

**RECEIVED** Must be filed with the K.C.C. five (5) days prior to commencing well completion. This card void if drilling not started within six (6) months of date received by K.C.C.  
 STATE CORPORATION COMMISSION

MAY 4 1985  
 5-4-85

CONSERVATION DIVISION  
 A Regular Section of Lands  
 1 Mile = 5,280 Ft.

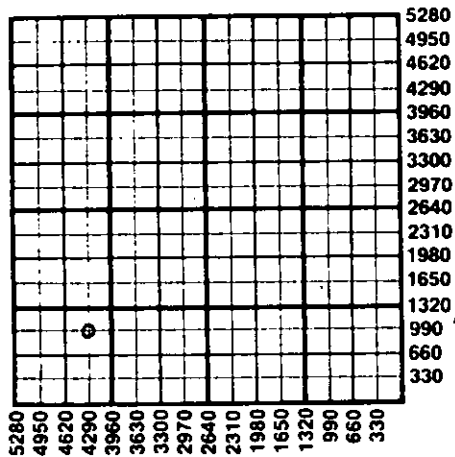

**Important procedures to follow :**

1. Notify District office before setting surface casing.
2. Set surface casing by circulating cement to the top.
3. File completion forms ACO-1 with K.C.C. within 90 days of well completion, following instructions on ACO-1, side 1, and including copies of wireline logs.
4. Notify District office 48 hours prior to old well workover or re-entry.
5. Prior to plugging, prepare a plugging plan, then obtain agreement from the appropriate district office for an approved plugging plan.
6. Submit plugging report (CP-4) to K.C.C. after plugging is completed.
7. Obtain an approved injection docket number before disposing of salt water.
8. Notify K.C.C. within 10 days when injection commences or terminates.
9. If an alternate 2 completion, cement in the production pipe from below any usable water to surface within 120 days of spud date.

State Corporation Commission of Kansas  
 Conservation Division  
 200 Colorado Derby Building  
 Wichita, Kansas 67202  
 (316) 263-3238