

CARD MUST BE TYPED

State of Kansas
NOTICE OF INTENTION TO DRILL
(see rules on reverse side)

CARD MUST BE SIGNED
AMENDED*
12-484

Starting Date: 11 20 84
month day year

API Number 15- 101-21,088 - 0000

OPERATOR: License # 9726

..... C SE NE Sec .28. Twp .17. S, Rge .28. East
(location) West

Name Gruss Petroleum Management, Inc.

Address 900 Building of the Southwest

City/State/Zip Midland, Texas 79701

Contact Person Earl W. Levea

Phone (915) 682-8319

..... 3300 Ft North from Southeast Corner of Section

..... 660 Ft West from Southeast Corner of Section

(Note: Locate well on Section Plat on reverse side)

CONTRACTOR: License # 5382

Name Cheyenne Drilling

City/State Garden City, Kansas

Nearest lease or unit boundary line 660 feet.

County Lane

Lease Name Bryant Well# 1

Domestic well within 330 feet: yes no

Municipal well within one mile: yes no

Well Drilled For: Well Class: Type Equipment:

- Oil Swd Infield Mud Rotary
- Gas Inj Pool Ext. Air Rotary
- OWWO Expl Wildcat Cable

Depth to Bottom of fresh water 150 feet

Lowest usable water formation Dakota

Depth to Bottom of usable water 1050 feet

Surface pipe by Alternate: 1 2

* Surface pipe to be set 388 feet

Conductor pipe if any required None

Ground surface elevation + 2660 feet MSL.

This Authorization Expires 5-9-85

Approved By 11-9-84
* was: 400'

If OWWO: old well info as follows:

Operator

Well Name

Comp Date Old Total Depth

Projected Total Depth 4600 feet

Projected Formation at TD Mississippian

Expected Producing Formations Lansing/Kansas City

I certify that we will comply with K.S.A. 55-101, et seq., plus eventually plugging hole to K.C.C. specifications.


* 388' of surface csg set, instead of 400' originally planned.

Date 11/27/84 Signature of Operator or Agent Title

Senior Engineer Drilling

Must be filed with the K.C.C. five (5) days prior to commencing well
 This card void if drilling not started within six (6) months of date received by K.C.C.

A Regular Section of Land
 1 Mile = 5,280 Ft.

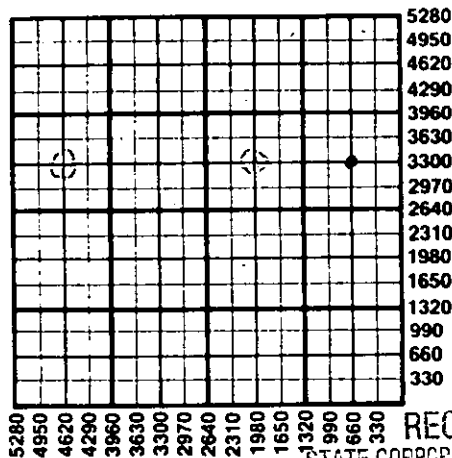

Important procedures to follow :

1. Notify District office before setting surface casing.
2. Set surface casing by circulating cement to the top.
3. File completion forms ACO-1 with K.C.C. within 90 days of well completion, following instructions on ACO-1, side 1, and including copies of wireline logs.
4. Notify District office 48 hours prior to old well workover or re-entry.
5. Prior to plugging, prepare a plugging plan, then obtain agreement from the appropriate district office for an approved plugging plan.
6. Submit plugging report (CP-4) to K.C.C. after plugging is completed.
7. Obtain an approved injection docket number before disposing of salt water.
8. Notify K.C.C. within 10 days when injection commences or terminates.
9. If an alternate 2 completion, cement in the production pipe from below any usable water to surface within 120 days of spud date.

RECEIVED
 STATE CORPORATION COMMISSION

State Corporation Commission of Kansas
 Conservation Division
 200 Colorado Derby Building
 Wichita, Kansas 67202
 (316) 263-3238

NOV 30 1984
 11-30-84
 CONSERVATION DIVISION
 Wichita, Kansas