

CARD MUST BE TYPED

State of Kansas
NOTICE OF INTENTION TO DRILL
(see rules on reverse side)

COLLECTION
CARD MUST BE SIGNED
9-14-84

Starting Date: ... September 15, 1984
month day year

API Number 15- 101-21,034-~~6000~~

OPERATOR: License # 6420
Name K.R.M. PETROLEUM CORPORATION
Address 1900 Grant Street, Suite 300
City/State/Zip Denver, Colorado 80203
Contact Person James Alan Townsend
Phone 303/830-6601

* E/2 E/2 .NW Sec .28 .Twp .17 .S. Rge 28. East
(location) West

* 3960' Ft North from Southeast Corner of Section
* 2970' Ft West from Southeast Corner of Section
(Note: Locate well on Section Plat on reverse side)

CONTRACTOR: License # 5829
Name ALDEBARAN DRILLING CO., INC.
City/State Wichita, Kansas 67218-0611

* Nearest lease or unit boundary line 330 feet.
County Lane
Lease Name Pelton Well# 1-28

Well Drilled For: Well Class: Type Equipment:
 Oil Swd Infield Mud Rotary
 Gas Inj Pool Ext. Air Rotary
 OWWO Expl Wildcat Cable

Domestic well within 330 feet: yes no
Municipal well within one mile: yes no

If OWWO: old well info as follows:

Operator
Well Name
Comp Date Old Total Depth
Projected Total Depth 4500' feet
Projected Formation at TD Mississippi
Expected Producing Formations Mississippi

Depth to Bottom of fresh water 150 feet
Lowest usable water formation Dakota
Depth to Bottom of usable water 1100 feet
Surface pipe by Alternate: 1 2
Surface pipe to be set 300 feet
Conductor pipe if any required feet
Ground surface elevation ± 2684' feet MSL
This Authorization Expires 2-27-85
Approved By 8-27-84

I certify that we will comply with K.S.A. 55-101, et seq., plus eventually plugging hole to K.C.C. specifications.


Date 9/10/84 Signature of Operator or Agent

[Signature]
Title Vice President-Operations
*was: SENEW 3300FSL 3300FEL

Must be filed with the K.C.C. five (5) days prior to commencing well
 This card void if drilling not started within six (6) months of date received by K.C.C.

Important procedures to follow:

A Regular Section of Land
1 Mile = 5,280 Ft.

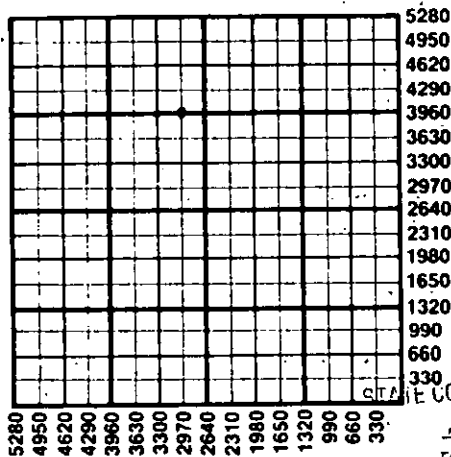

1. Notify District office before setting surface casing.
 2. Set surface casing by circulating cement to the top.
 3. File completion forms ACO-1 with K.C.C. within 90 days of well completion, following instructions on ACO-1, side 1, and including copies of wireline logs.
 4. Notify District office 48 hours prior to old well workover or re-entry.
 5. Prior to plugging, prepare a plugging plan, then obtain agreement from the appropriate district office for an approved plugging plan.
 6. Submit plugging report (CP-4) to K.C.C. after plugging is completed.
 7. Obtain an approved injection docket number before disposing of salt water.
 8. Notify K.C.C. within 10 days when injection commences or terminates.
- or an alternate 2 completion, cement in the production pipe from below any usable water to surface within 120 days of spud date.

RECEIVED
 SEP 13 1984
 9-13-84
 CONSERVATION DIVISION
 Wichita, Kansas

State Corporation Commission of Kansas
 Conservation Division
 200 Colorado Derby Building
 Wichita, Kansas 67202
 (316) 263-3238